

Washington
 5 2022
 11/14/77

MISSISSIPPI
 BOARD OF WATER COMMISSIONERS
 416 North State Street
 Jackson, Mississippi 39201

WATER WELL DRILLERS LOG

14 Nov. 1977 Lambert Drilling Wash
 date well completed firm name county well located

LANDOWNER:	description of formations encountered	from	to
Morrison Childs Greenville, Miss. (mailing address)			
WELL LOCATION: sec 20 T 17 N R 9 E 9 miles S/W of Greenville (distance) (direction) (nearest town)	Sand.	0	30
WELL PURPOSE: none (home, irrigation, municipal, industrial)	Sand & gravel	30	98
WELL COMPLETION DATA: (1) diameter (inches) 4x2 (2) total depth (feet) 450 (3) static water level (feet) 38 below top of ground. (4) casing PVC 430 (material) (depth) 4x2 (size) if telescope see back. (5) screen 20 450-430 (length) (depth to top) 2" PVC (size) (material) (6) pump 2 30 (HP) (yield gpm) elect (type power) (7) electric log <input checked="" type="checkbox"/> (yes or no) (organization running log) (8) how well bottom plugged back wash.	Clay	98	240
	ROCK	240	241
	Clay & Sand.	241	395
	rock	395	396
	Sand. good.	396	450
DRILLERS REMARKS:			

RECEIVED
 DEC 9 1977


If well telescopes please sketch and show depths.

GROUND LEVEL

140 4"

290 2"

20 2"

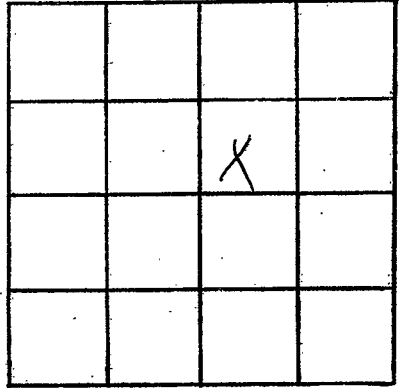

SECTION 20

Please indicate well location X.

ADDITIONAL INFORMATION

If more than one screen, show locations of each on sketch.