

WASHINGTON
 G 2023
 6-2-78

MISSISSIPPI
 BOARD OF WATER COMMISSIONERS
 416 North State Street
 Jackson, Mississippi 39201

WATER WELL DRILLERS LOG

6-2 1978 Schulte Drilling Co Washington
 date well completed firm name county well located

LANDOWNER: John Cooper
 Bayou Rd.
 Greenville MS
 (mailing address)

WELL LOCATION:
 sec. 16 T. 17 N. R. 9 E
 3 miles SW of Greenville
 (distance) (direction) (nearest town)

WELL PURPOSE: HOME
 (home, irrigation, municipal, industrial)

WELL COMPLETION DATA:

(1) diameter (inches) 4 1/2
 (2) total depth (feet) 480
 (3) static water level (feet) 32 below above top of ground.
 (4) casing (material) PVC, (depth) 460 ft
 (size) if telescope see back.
 (5) screen 20 ft, 460 ft
 (length) (depth to top)
 2 in. PVC
 (size) (material)
 (6) pump 1 19
 (HP) (yield gpm)
 ele
 (type power)
 (7) electric log NO
 (yes or no)
 (organization running log)
 (8) how well bottom plugged b/w

description of formations encountered	from	to
Clay	0	13
SAND	13	101
Clay	101	200
Sandy Shale	200	380
FINE SAND	380	420
SAND	420	480

DRILLERS REMARKS:

RECEIVED
 JUN 12 1978
 MISS. BD. OF WATER COMMISSIONERS

If well telescopes please sketch and show depths.


GROUND LEVEL

120 ft
4 in
PVC

2 in
PVC
340 ft

Screen
pvc
2 in
20 ft

480 ft

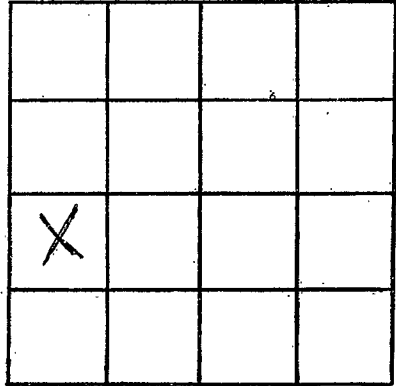

SECTION 16

Please indicate well location X.

ADDITIONAL INFORMATION

If more than one screen,
show locations of each on sketch.