

WASHINGTON

2024 G  
6-5-78

MISSISSIPPI  
BOARD OF WATER COMMISSIONERS  
416 North State Street  
Jackson, Mississippi 39201

WATER WELL DRILLERS LOG

6-5 1978 Schultz Drilling Co Washington  
date well completed firm name county well located

LANDOWNER: LEON Lumley  
Wilmont Road  
Greenville MS.  
(mailing address)


description of formations encountered	depth	
	from	to
Clay	0	38
Med sand	40	60
Coarse Sand + gravel	60	80

WELL LOCATION:  
sec 3 T 11 N R 8 E  
7 S of Greenville  
(distance) miles (direction) of (nearest town)

WELL PURPOSE: domestic  
(home, irrigation, municipal, industrial)

- WELL COMPLETION DATA:
- (1) diameter (inches) 4 in
  - (2) total depth (feet) 80 ft
  - (3) static water level (feet) 19 below top of ground
  - (4) casing PVC 70 ft (material) (depth)
  - (size) If telescope see back.
  - (5) screen 10 ft 70 ft (length) (depth to top)
  - 4 in PVC (size) (material)
  - (6) pump 1 (HP) 19 (yield gpm)
  - ele (type power)
  - (7) electric log NO (yes or no)
  - (organization running log)
  - (8) how well bottom plugged plug


DRILLERS REMARKS:

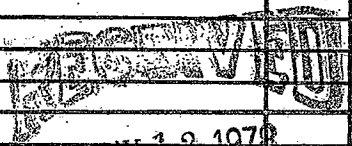

MISS. BD. OF WATER COMMISSIONERS

If well telescopes please sketch and show depths.

GROUND LEVEL

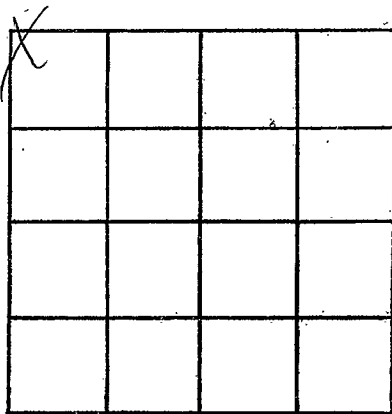

SECTION 3D

Please indicate well location X.

ADDITIONAL INFORMATION

If more than one screen,  
show locations of each on sketch.