

WASH
 Lb 2025
 1/12/78

MISSISSIPPI
 BOARD OF WATER COMMISSIONERS
 416 North State Street
 Jackson, Mississippi 39201

WATER WELL DRILLERS LOG

11-12 date well completed
 Schultz Drilling firm name
 Washington county well located

LANDOWNER: Leland Lanning
 RT. 2
 Baconville Ms.
 (mailing address)

description of formations encountered	from to	
Clay	0	43
Sand	43	84
Clay & shale	84	380
Sand	380	440

WELL LOCATION:
 sec. 15 T. 19 N. R. 8 E. S. 3
 3 miles 5 of Cull
 (distance) (direction) (nearest town)

WELL PURPOSE: Home
 (home, irrigation, municipal, industrial)

- WELL COMPLETION DATA:
- (1) diameter (inches) 2"
 - (2) total depth (feet) 440
 - (3) static water level (feet) 38 below above top of ground.
 - (4) casing P.V.C. (material) (depth)
 (size) if telescope see back.
 - (5) screen 10 (length) (depth to top)
2 (size) P.V.C. (material)
 - (6) pump 1 (HP) 10 (yield gpm)
ele (type power)
 - (7) electric log N (yes or no)
 (organization running log)
 - (8) how well bottom plugged flush
valve


DRILLERS REMARKS:

RECEIVED
 FEB - 2 1978

MISS. BD. OF WATER COMMISSIONERS

If well telescopes please sketch and show depths.

GROUND LEVEL

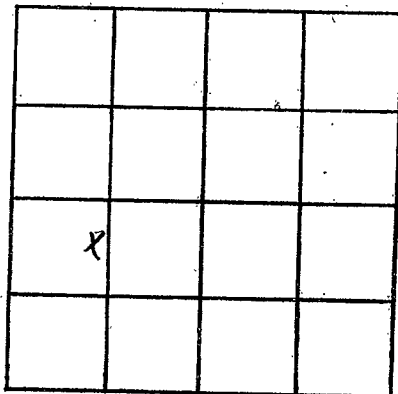

SECTION 15

Please indicate well location X.

ADDITIONAL INFORMATION

If more than one screen,
show locations of each on sketch.