

WASHINGTON  
 G 20260  
 5-29-78

MISSISSIPPI  
 BOARD OF WATER COMMISSIONERS  
 416 North State Street  
 Jackson, Mississippi 39201

WATER WELL DRILLERS LOG

29 May 1978 Lambert Drilling Wash  
 date well completed firm name county well located

LANDOWNER:	description of formations encountered	from	to
Ed Engles Green V. 1/2 Miss. (mailing address)			
WELL LOCATION: sec 13 T 17 N R 8 E 10 2 miles S of Arceneville (distance) (direction) (nearest town)	Sand	35	80
WELL PURPOSE: home (home, irrigation, municipal, industrial)	gravel	80	95
WELL COMPLETION DATA: (1) diameter (inches) 4x2 (2) total depth (feet) 400 (3) static water level (feet) 42 below top of ground. (4) casing PVC 380 (material) (depth) 40 (size) if telescope see back. (5) screen 20 400-380 (length) (depth to top) 2 PVC (size) (material) (6) pump 1 20 (HP) (yield gpm) elect (type power) (7) electric log no (yes or no) (organization running log) (8) how well bottom plugged back press	Clay	95	180
	Clay & Sand	180	320
	Sand tight	320	335
	Sand good	335	420
DRILLERS REMARKS:			

RECEIVED  
 SEP - 8 1978

MISS. BD. OF WATER COMM.


If well telescopes please sketch and show depths.

GROUND LEVEL

140 4''

380 2''

400 2'' scv.

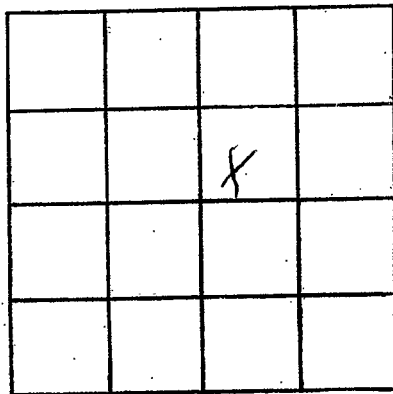

SECTION 13

Please indicate well location X.

ADDITIONAL INFORMATION

If more than one screen,  
show locations of each on sketch.