

WASHINGTON
G 2007
5-25-78

MISSISSIPPI
BOARD OF WATER COMMISSIONERS
416 North State Street
Jackson, Mississippi 39201

WATER WELL DRILLERS LOG

25 May 1978 Lambert Drilling Wash
date well completed firm name county well located

LANDOWNER:	description of formations encountered	from	to
Milton Taylor Greenville, Miss. (mailing address)			
WELL LOCATION: sec. 13 T 17 N R. 8 E W 10 3/4 miles S of Greenville (distance) (direction) (nearest town)	Clay	0	46
	sand.	40	80
	poor gravel	80	115
	Clay	115	225
WELL PURPOSE: home (home, irrigation, municipal, industrial)	Clay st sand.	225	250
WELL COMPLETION DATA:	Sand. good.	250	360
(1) diameter (inches) 4X2	Sand. II	360	410
(2) total depth (feet) 400			
(3) static water level (feet) 42 below top of ground. above			
(4) casing PVC 380 (material) (depth) 4X2 if telescope see back. (size)			
(5) screen 20' 400-380 (length) (depth to-top) 2" PVC (size) (material)			
(6) pump 1 20 (HP) (yield gpm) elect (type power)			
(7) electric log (yes or no)			
(organization running log)			
(8) how well bottom plugged beck press.			
DRILLERS REMARKS:			

RECEIVED
SEP - 8 1978

MISS. BD. OF WATER COMMISSIONERS


If well telescopes please sketch and show depths.

GROUND LEVEL

170 4"

380 2"

400 2" screen

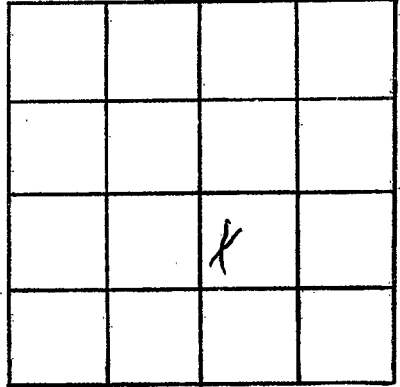

SECTION 13

Please indicate well location X.

ADDITIONAL INFORMATION

If more than one screen, show locations of each on sketch.