

WASHINGTON

G 2028

8-23-78

MISSISSIPPI BOARD OF WATER COMMISSIONERS
416 North State Street
Jackson, Mississippi 39201

WATER WELL DRILLERS LOG

28 Aug
date well completed

1978 Lambert Drilling Wash
firm name

Wash
county well located

LANDOWNER:	description of formations encountered	from	to
Oran a. Clements, Greenville, Miss (mailing address)			
WELL LOCATION:	Sand & gravel	60	90
sec 38 T 17 N R 8 E 6 miles S E of Greenville (distance) (direction) (nearest town)	Clay	90	150
WELL PURPOSE: <u>Swm</u> (home, irrigation, municipal, industrial)	Clay st Sand	150	290
WELL COMPLETION DATA:	Sand st clay	290	340
(1) diameter (inches) <u>4x2</u>	Sand, met	340	410
(2) total depth (feet) <u>460</u>	Sand	410	460
(3) static water level (feet) <u>38</u> below above top of ground.			
(4) casing <u>PVC</u> , <u>440</u> , (material) (depth) <u>4x2</u> if telescope see back. (size)			
(5) screen <u>20</u> , <u>460-440</u> (length) (depth to top) <u>2</u> , <u>PVC</u> (size) (material)			
(6) pump <u>1</u> , <u>20</u> (HP) (yield gpm) <u>elect</u> (type power)			
(7) electric log <u>no</u> (yes or no)			
(organization running log)			
(8) how well bottom plugged <u>back pass.</u>			
DRILLERS REMARKS:			

RECEIVED
SEP - 8 1978

MISS. BD. OF WATER COMM


If well telescopes please sketch and show depths.

GROUND LEVEL

~~140~~ 4"

~~140~~ 2"

~~400~~ 2" 50v

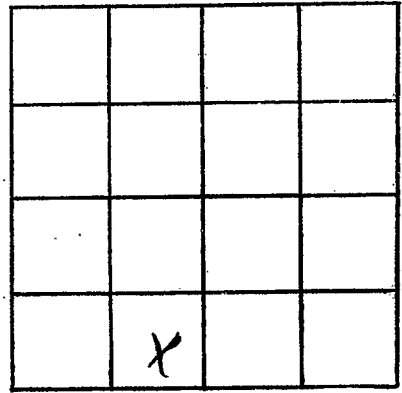

SECTION 38

Please indicate well location X.

ADDITIONAL INFORMATION

If more than one screen, show locations of each on sketch.