

WASHINGTON

G 2005

3-29-78

MISSISSIPPI BOARD OF WATER COMMISSIONERS 416 North State Street Jackson, Mississippi 39201

WATER WELL DRILLERS LOG

March 29 1978 Schultz Drilling Co Washington date well completed firm name county well located

LANDOWNER	Description of formations encountered	from	to
Hales Construction Co. Greenville, MS	Clay	0	40
38701 (mailing address)	Sand + pea gravel	40	88
WELL LOCATION: sec. 15 T. 17 N. R. 8 E. 3 miles S of Greenville (distance) (direction) (nearest town)	Sandy shale & clay	88	380
WELL PURPOSE: Home (home, irrigation, municipal, industrial)	Sand	380	440
WELL COMPLETION DATA:			
(1) diameter (inches) 2"			
(2) total depth (feet) 440 ft			
(3) static water level (feet) 38 below top of ground.			
(4) casing PVC 430 (material) (depth)			
2" If telescope see back. (size)			
(5) screen 10 ft 430 (length) (depth to top)			
2" PVC (size) (material)			
(6) pump 1 (HP) 10 (yield gpm)			
ele (type power)			
(7) electric log NO (yes or no)			
(organization running log)			
(8) how well bottom plugged B/w			
DRILLERS REMARKS:			


RECEIVED

DEC 27 1978

MISS. BD. OF WATER COMMISSIONERS

If well telescopes please sketch and show depths.

GROUND LEVEL

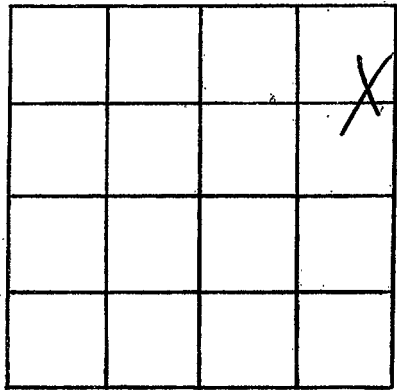

SECTION \_\_\_\_\_

Please indicate well location X.

ADDITIONAL INFORMATION

If more than one screen,  
show locations of each on sketch.