

Washington
G
2030
10/2/78

MISSISSIPPI
 BOARD OF WATER COMMISSIONERS
 416 North State Street
 Jackson, Mississippi 39201

WATER WELL DRILLERS LOG

2 Oct 1978 Lambert Dr. Hwy Wash
 date well completed firm name county well located

LANDOWNER:	description of formations encountered	from	to
<u>D. T. Graham</u>			
<u>Greenwood, Miss.</u> (mailing address)	<u>Mixed</u>	<u>0</u>	<u>15</u>
WELL LOCATION: sec <u>13</u> T <u>17</u> N R <u>8</u> E <u>10</u> miles <u>S</u> of <u>Greenwood, Miss.</u> (distance) (direction) (nearest town)	<u>Clay</u>	<u>15</u>	<u>40</u>
WELL PURPOSE: <u>home</u> (home, irrigation, municipal, industrial)	<u>Sand, light</u>	<u>40</u>	<u>80</u>
WELL COMPLETION DATA: (1) diameter (inches) <u>4 x 2</u> (2) total depth (feet) <u>420 ft.</u> (3) static water level (feet) <u>46</u> below above top of ground. (4) casing <u>PVC</u> , <u>400</u> , (material) (depth) <u>4 x 2</u> if telescope see back. (size) (5) screen <u>20'</u> , <u>420-400</u> (length) (depth to top) <u>2"</u> <u>PVC</u> (size) (material) (6) pump <u>1</u> <u>20</u> (HP) (yield gpm) <u>elect</u> (type power) (7) electric log <u>no</u> (yes or no) (organization running log) (8) how well bottom plugged <u>back press</u>	<u>Per gravel</u>	<u>80</u>	<u>110</u>
	<u>Clay</u>	<u>110</u>	<u>200</u>
	<u>Clay st sand.</u>	<u>200</u>	<u>315</u>
	<u>Sand, light</u>	<u>315</u>	<u>360</u>
	<u>Sand, good.</u>	<u>360</u>	<u>420</u>
DRILLERS REMARKS:			

Miss. Board of Water Comm.

APR 4 1979

RECEIVED


If well telescopes please sketch and show depths.

GROUND LEVEL

4" 140

2" 400

2" 506 420

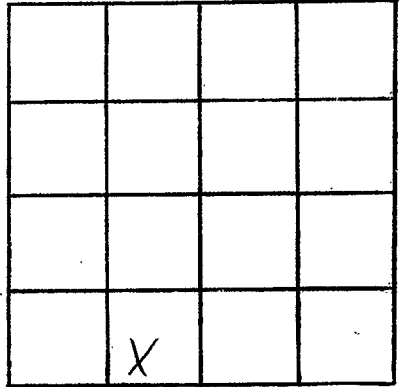

SECTION 13

Please indicate well location X.

ADDITIONAL INFORMATION

If more than one screen, show locations of each on sketch.