

Washington
G

MISSISSIPPI
BOARD OF WATER COMMISSIONERS
416 North State Street
Jackson, Mississippi 39201

2032
8-28-79

WATER WELL DRILLERS LOG

8-28
date well completed

1979 Owens Plbg.
firm name

Wash
county well located

LANDOWNER: LRE
moore Rt 2, Box
283 Greenville, MS, 38701
(mailing address)

description of formations encountered	from	to
top soil	0	17'
sand	17	140'
clay	140	180'
sand + gravel	180	240'
sand (coarse)	240	310'
sand	310	480'

WELL LOCATION:
sec. 15 T. 17 N. R. 9 E
3 miles west of Greenville
(distance) (direction) (nearest town)

WELL PURPOSE: home
(home, irrigation, municipal, industrial)

- WELL COMPLETION DATA:
- (1) diameter (inches) 2"
 - (2) total depth (feet) 480'
 - (3) static water level (feet) 19' above top of ground
 - (4) casing PVC 460'
(material) (depth)
 - (size) if telescope see back.
 - (5) screen 20' 480'
(length) (depth to top)
 - 2" PVC
(size) (material)
 - (6) pump 1-HP 12
(HP) (yield gpm)
 - Elec.
(type power)
 - (7) electric log no
(yes or no)
 - (organization running log)
 - (8) how well bottom plugged S/B

DRILLERS REMARKS:
Owens


Miss. Board of Water Comm.

SEP 12 1979

RECEIVED

If well telescopes please sketch and show depths.

GROUND LEVEL

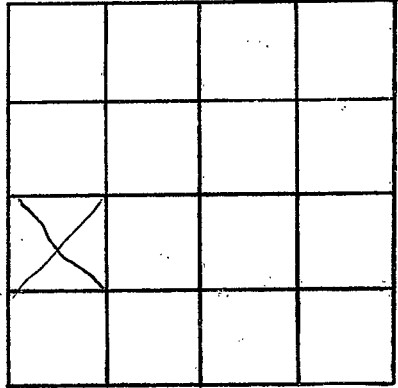

SECTION 15

Please indicate well location X.

ADDITIONAL INFORMATION

If more than one screen, show locations of each on sketch.