

Wash.
G 2034
4-22-79

MISSISSIPPI
BOARD OF WATER COMMISSIONERS
416 North State Street
Jackson, Mississippi 39201

WATER WELL DRILLERS LOG

22 Apr 79 Lambert Drilling Wash
date well completed firm name county well located

LANDOWNER:	description of formations encountered	from	to
C.A. Duprell Swiftwater, Miss. (mailing address)			
WELL LOCATION: sec. 15 T. 17 N. R. 8 E 8 miles SE of Greenville (distance) (direction) (nearest town)	Coarse Sand	30	87
WELL PURPOSE: home (home, irrigation, municipal, industrial)	blue shell	83	160
WELL COMPLETION DATA: (1) diameter (inches) 4x2 (2) total depth (feet) 550 (3) static water level (feet) 48 below top of ground. (4) casing PVC, 440 (material) (depth) 4x2 (size) if telescope see back. (5) screen 20, 440-440 (length) (depth to top) 2" PVC (size) (material) (6) pump 1, 20 (HP) (yield gpm) elect (type power) (7) electric log (yes or no) (organization running log) (8) how well bottom plugged back press	Clay st Sand	160	211
	Sand med	210	246
	Clay st sand	246	311
	Sand med	360	400
	Sand gravel	400	460
DRILLERS REMARKS:			

Miss. Board of Water Comm

SEP 13 1979

RECEIVED

If well telescopes please sketch and show depths.


GROUND LEVEL

140 4"



440 2M

460 2" screen

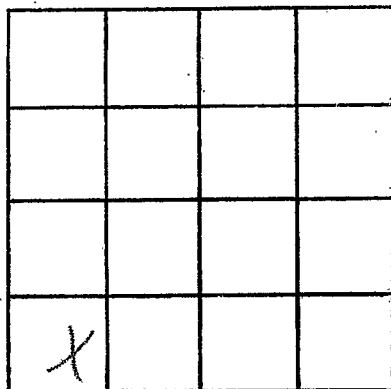

SECTION 15

Please indicate well location X.

ADDITIONAL INFORMATION

If more than one screen, show locations of each on sketch.