

Wash.
G 2035
8-2-79

MISSISSIPPI
BOARD OF WATER COMMISSIONERS
416 North State Street
Jackson, Mississippi 39201

WATER WELL DRILLERS LOG

2 Aug 1979 Lambert Drilling Wash
date well completed firm name county well located

LANDOWNER:	description of formations encountered	from	to
(mailing address)			
W. Card	clay	0	30
Greenville, Miss.	sand & gravel	30	80
sec 24 T 17 N R 8 E W	clay	80	170
10 miles S of Greenville	clay st sand	170	330
(distance) (direction) (nearest town)	sand st clay	330	410
WELL PURPOSE: home	sand med.	410	440
(home, irrigation, municipal, industrial)	sand good	440	480
WELL COMPLETION DATA:			
(1) diameter (inches) 4x2			
(2) total depth (feet) 490			
(3) static water level (feet) 42 below above top of ground.			
(4) casing PVC, 470 (material) (depth)			
4x2 (size) if telescope see back.			
(5) screen 20, 490-470 (length) (depth to top)			
2" PVC (size) (material)			
(6) pump 1, 20 (HP) (yield gpm)			
elect (type power)			
(7) electric log (yes or no)			
(organization running log)			
(8) how well bottom plugged back press			

DRILLERS REMARKS:

DEPT. OF NATURAL RESOURCES
BUREAU OF LAND & WATER RESOURCES
JAN 9 1980
RECEIVED


If well telescopes please sketch and show depths.

GROUND LEVEL

4" 140

2" 470

Scr. 2" 490

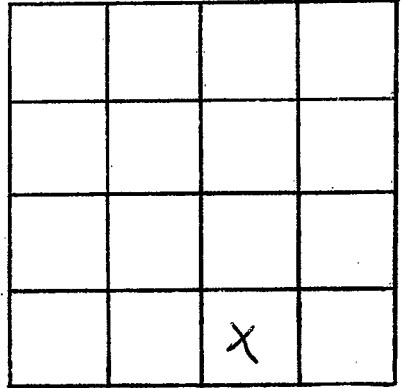

SECTION 24

Please indicate well location X.

ADDITIONAL INFORMATION

If more than one screen, show locations of each on sketch.