

Wash.
G 2038
11-16-79

MISSISSIPPI
BOARD OF WATER COMMISSIONERS
416 North State Street
Jackson, Mississippi 39201

WATER WELL DRILLERS LOG

16 Nov. 1979 Lambert Drilling Co Wash
date well completed firm name county well located

| LANDOWNER: | description of formations encountered | from | to |
|---|---------------------------------------|------|-----|
| (mailing address) | | | |
| Rosco Soules Greenville, Miss. | Mixed | 0 | 4 |
| WELL LOCATION: sec. 20 T. 17 N. R. 8 E. S. W. | Sand | 4 | 60 |
| 9 miles S of Green (distance) (direction) (nearest town) | Pea grav | 100 | 105 |
| WELL PURPOSE: home (home, irrigation, municipal, industrial) | blue clay shell | 105 | 240 |
| WELL COMPLETION DATA: | Clay st sand | 240 | 360 |
| (1) diameter (inches) 2 | Clay | 360 | 405 |
| (2) total depth (feet) 525 | Sand st Clay | 465 | 470 |
| (3) static water level (feet) 38 below top of ground. | Sand tight | 470 | 495 |
| (4) casing PVC, 515 (material) (depth) | Sand good | 495 | 525 |
| (size) If telescope see back. | | | |
| (5) screen 10, 525-515 (length) (depth to top) | | | |
| 2, PVC (size) (material) | | | |
| (6) pump 1 (HP) 10 (yield gpm) | | | |
| elect (type power) | | | |
| (7) electric log (yes or no) | | | |
| (organization running log) | | | |
| (8) how well bottom plugged lock post. | | | |
| DRILLERS REMARKS: | | | |


DEPT. OF NATURAL RESOURCES
BUREAU OF LAND & WATER RESOURCES

JAN 7 1980

RECEIVED

If well telescopes please sketch and show depths.

GROUND LEVEL

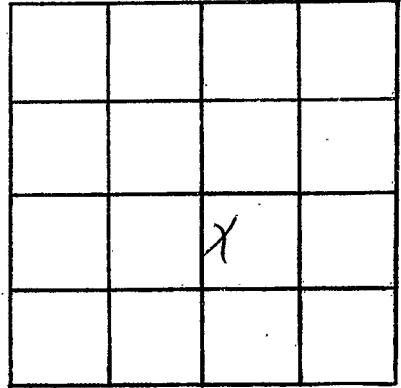

SECTION 20

Please indicate well location X.

ADDITIONAL INFORMATION

If more than one screen,
show locations of each on sketch.