

Wash.
 G 2037
 11-28-79

MISSISSIPPI
 BOARD OF WATER COMMISSIONERS
 416 North State Street
 Jackson, Mississippi 39201

WATER WELL DRILLERS LOG

28 Nov 1979 Lambert Drilling Co. West
 date well completed firm name county well located

LANDOWNER:	description of formations encountered	from	to
(mailing address)			
M.R. Williams	Clay	0	18
WELL LOCATION:	Sand.	18	60
sec. 8 T. 17 N. R. 8 E. W. 5 miles S of Greenville	Sandgravel	60	98
(distance) (direction) (nearest town)	blue clay shd	98	160
WELL PURPOSE: home	clay	160	280
(home, irrigation, municipal, industrial)	clay & sand	280	360
WELL COMPLETION DATA:	Sand. fine	360	405
(1) diameter (inches) 4x2	Sand. good	405	465
(2) total depth (feet) 465			
(3) static water level (feet) 84 below top of ground.			
(4) casing PVC, 445 (material) (depth) 2x4 if telescope see back. (size)			
(5) screen 20, 465-445 (length) (depth to top) 2" PVC (size) (material)			
(6) pump 1 (HP) 20 (yield gpm) elect (type power)			
(7) electric log (yes or no)			
(organization running log)			
(8) how well bottom plugged back press.			
DRILLERS REMARKS:			

DEPT. OF NATURAL RESOURCES
 BUREAU OF LAND & WATER RESOURCES

JAN 7 1980

RECEIVED


If well telescopes please sketch and show depths.

GROUND LEVEL

4" 140

2" 445

SCV, 2" 465

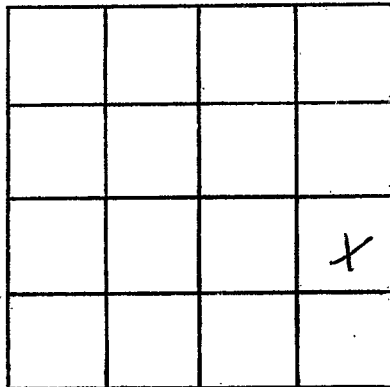

SECTION 8

Please indicate well location X.

ADDITIONAL INFORMATION

If more than one screen, show locations of each on sketch.