

Washington  
G 2040

MISSISSIPPI  
BOARD OF WATER COMMISSIONERS  
416 North State Street  
Jackson, Mississippi 39201

3-13-80  
3-13

WATER WELL DRILLERS LOG

date well completed 19 80 Owens Plog firm name Wash county well located

LANDOWNER: Sunrise  
Baptist Ch. Wilmount  
Rd. Grenville, MS 38701  
(mailing address)

description of formations encountered	from	to
top soil	0	17
clay	17	80
clay	80	120
clay	120	210
sand & gravel	210	270
clay	270	310
sand	310	410

WELL LOCATION:  
sec. 30 T17N R 8 E  
S W  
Grenville, MS  
(distance) (direction) (nearest town)

WELL PURPOSE: church  
(home, irrigation, municipal, industrial)


- WELL COMPLETION DATA:
- (1) diameter (inches) 2"
  - (2) total depth (feet) 410'
  - (3) static water level (feet) 17 below top of ground.
  - (4) casing PVC 400'  
(material) (depth)
  - (size) If telescope see back.
  - (5) screen 10' 410'  
(length) (depth to top)
  - 2" PVC  
(size) (material)
  - (6) pump 1 12  
(HP) (yield gpm)
  - elec.  
(type power)
  - (7) electric log NO  
(yes or no)
  - (organization running log)
  - (8) how well bottom plugged S/B

DRILLERS REMARKS:  
Owens

DEPT. OF NATURAL RESOURCES  
BUREAU OF LAND & WATER RESOURCES  
APR 29 1980  
RECEIVED

If well telescopes please sketch and show depths.

GROUND LEVEL

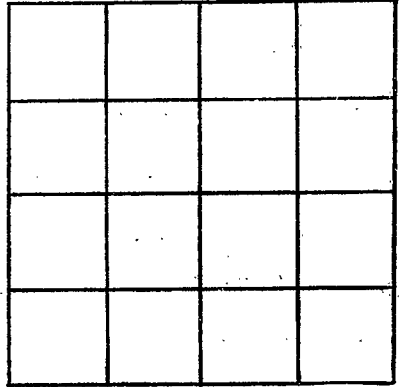

SECTION \_\_\_\_\_

Please indicate well location X.

ADDITIONAL INFORMATION

If more than one screen, show locations of each on sketch.