

Washington
G 2042

MISSISSIPPI
BOARD OF WATER COMMISSIONERS
416 North State Street
Jackson, Mississippi 39201

WATER WELL DRILLERS LOG

12-22-80
12-22-80

1980 Schultz Drilling

Washington

date well completed

firm name


county well located

LANDOWNER:	description of fomations encountered	from	to
J. Matthe Wayside MS 38780 (mailing address)	Clay Clay sandy	0 20 31	20 31 80
WELL LOCATION: sec. 10 T. 17 N. R. 8 E S W 2 miles EAST of Wayside (distance) (direction) (nearest town)	Clay and sandy clay SAND.	80 300	300 400
WELL PURPOSE: Home (home, irrigation, municipal, industrial)			
WELL COMPLETION DATA: (1) diameter (inches) 2" (2) total depth (feet) 400 (3) static water level (feet) 29 below top of ground. (4) casing 2" PVC 390' (material) (depth) (size) If telescope see back. (5) screen 10" 390' (length) (depth to top) 2" PVC (size) (material) (6) pump 1 10 (HP) (yield gpm) etc. (type power) (7) electric log NO (yes or no) (organization running log) (8) how well bottom plugged b/w			
DRILLERS REMARKS:			

DEPT. OF NATURAL RESOURCES
BUREAU OF LAND & WATER RESOURCES
RECEIVED
JAN 26 1981

If well telescopes please sketch and show depths.

GROUND LEVEL

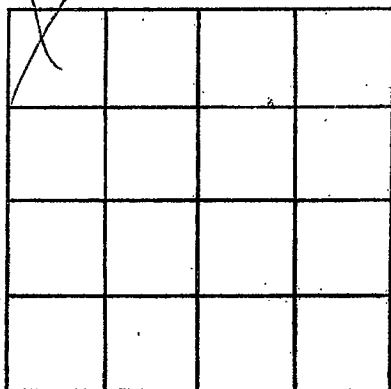

SECTION _____

Please indicate well location X.

ADDITIONAL INFORMATION

If more than one screen,
show locations of each on sketch.