

Washington
G 2053

MISSISSIPPI
BOARD OF WATER COMMISSIONERS
416 North State Street
Jackson, Mississippi 39201

1-8-81
1-8

WATER WELL DRILLERS LOG

1981 Schultz Drilling Washington
date well completed firm name county well located

LANDOWNER: Mike Kuhn
Maxton Rd
Greenville MS.
(mailing address)

description of formations encountered	from	to
CLAY	0	20
SAND	20	85
CLAY and SANDY CLAY	85	380
SAND	380	470

WELL LOCATION:
sec. 5 T. 17 S. R. 8 E
3 miles S of Greenville
(distance) (direction) (nearest town)

WELL PURPOSE: HOME
(home, irrigation, municipal, industrial)

- WELL COMPLETION DATA:
- (1) diameter (inches) 2
 - (2) total depth (feet) 470'
 - (3) static water level (feet) 38' below top of ground.
 - (4) casing PVC 460' (material) (depth)
 - (5) screen 10' 460' (length) (depth to top)
2" PVC (size) (material)
 - (6) pump 1HP 10 (HP) (yield gpm)
E/E (type power)
 - (7) electric log NO (yes or no)
 - (8) how well bottom plugged b/w


DRILLERS REMARKS:

DEPT. OF NATURAL RESOURCES
BUREAU OF LAND & WATER RESOURCES

JAN 26 1981
RECEIVED

If well telescopes please sketch and show depths.

GROUND LEVEL

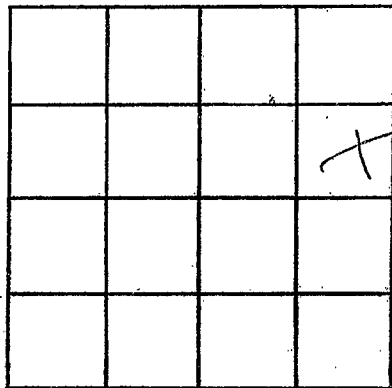

SECTION _____

Please indicate well location X.

ADDITIONAL INFORMATION

If more than one screen,
show locations of each on sketch.