

WASHINGTON

G 2045.1

8-25-81

MISSISSIPPI BOARD OF WATER COMMISSIONERS
416 North State Street
Jackson, Mississippi 39201

WATER WELL DRILLERS LOG

8-25

date well completed

1981 Owens Plug.

firm name

Wash.

county well located

LANDOWNER: Sylvester White

description of formations encountered

from

to

848 Ireys St
Biville, MS 38701
(mailing address)

top soil	0	30'
Clay	30	100
gravel	100	140
Clay	140	210
Sand	210	242
gravel	242	260
Clay	260	280
mixed sand - and gravel	280	310
Sand	310	480

WELL LOCATION:

sec 21 T. 17 N. R. 9 E
0 miles S of Biville
(distance) (direction) (nearest town)

WELL PURPOSE: ~~HOME~~
(home, irrigation, municipal, industrial)

WELL COMPLETION DATA:

- (1) diameter (inches) 4" x 2"
- (2) total depth (feet) 480'
- (3) static water level (feet) 38' below top of ground.
- (4) casing PVC 460' (material) (depth)
- (size) If telescope see back.
- (5) screen 20" 480' (length) (depth to top)
- 2" PVC (size) (material)
- (6) pump 1 12 (HP) (yield gpm)
- Elec (type power)
- (7) electric log NO (yes or no)
- (organization running log)
- (8) how well bottom plugged S/B

RECEIVED

SEP 18 1981

DEPARTMENT OF NATURAL RESOURCES

DEPT. OF NATURAL RESOURCES
BUREAU OF LAND & WATER RESOURCES

SEP 18 1981


RECEIVED

DRILLERS REMARKS:

Owens

If well telescopes please sketch and show depths.

GROUND LEVEL

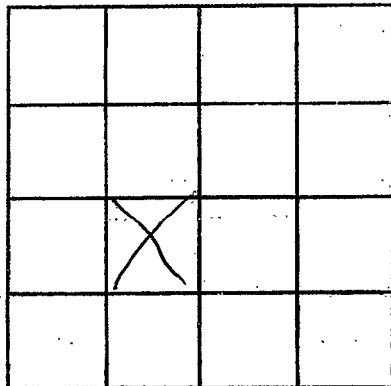

SECTION A

Please indicate well location X.

ADDITIONAL INFORMATION

If more than one screen, show locations of each on sketch.