




If well telescopes please sketch and show depths.

GROUND LEVEL

140 4'

445 2'

465 2" 50'

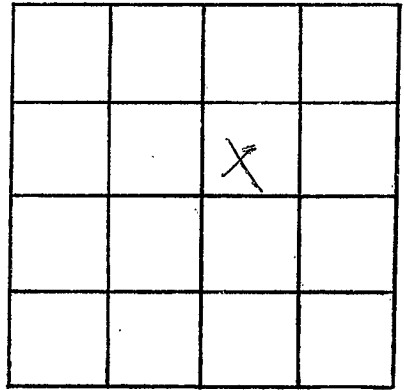

SECTION 13

Please indicate well location X.

ADDITIONAL INFORMATION

If more than one screen, show locations of each on sketch.