

**MISSISSIPPI DEPARTMENT OF NATURAL RESOURCES**  
**Bureau of Land and Water Resources**  
 Southport Mall  
 P.O. Box 10631  
 Jackson, Mississippi 39209  
**WATER WELL DRILLERS LOG**

Washington  
G  
2048

6-1 1988 Schultz Drilling Washington  
 date well completed firm name county well located

LANDOWNER: Bill Kerth  
Rt 2  
Greenville, Ms  
 (mailing address)

description of formations encountered	from	to
	clay	0
sand	43	84
clay shale	84	380
sand	380	430

WELL LOCATION:  
 sec. 15 T. 17 N. R. 8 E. W  
3 miles S of Grvc  
 (distance) (direction) (nearest town)

WELL PURPOSE: home  
 (home, irrigation, municipal, industrial)

- WELL COMPLETION DATA:
- diameter (inches) 4" x 2"
  - total depth (feet) 430'
  - static water level (feet) 38 below above top of ground.
  - casing PVC 420'  
 (material) (depth)  
4" x 2" if telescope see back.  
 (size)
  - screen 10' 10'  
 (length) (depth to top)  
2" PVC  
 (size) (material)
  - pump 1 19  
 (HP) (yield gpm)  
elec  
 (type power)
  - electric log no  
 (yes or no)  
 (organization running log)
  - how well bottom plugged b/w

DRILLERS REMARKS:

DEPT. OF NATURAL RESOURCES  
 BUREAU OF LAND & WATER RESOURCES

JUN - 8 1988

RECEIVED

If well telescopes please sketch and show depths.


GROUND LEVEL

4<sup>01</sup> 1300 ft

2 300 ft

5<sup>04</sup>  
500 ft

10

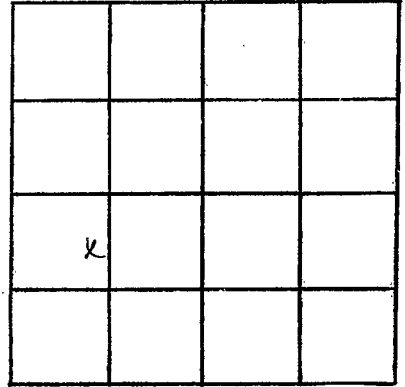

SECTION \_\_\_\_\_

Please indicate well location X.

ADDITIONAL INFORMATION

If more than one screen, show locations of each on sketch.