

MISSISSIPPI DEPARTMENT OF NATURAL RESOURCES

Bureau of Land and Water Resources

Southport Mall

P.O. Box 10631

Jackson, Mississippi 39209

WATER WELL DRILLERS LOG

Washington
G
2049

DEC 2 1982 Schultz Drilling Washington
 date well completed firm name county well located

LANDOWNER: LEON Burnley
Rt. 2 Box 685
GREENVILLE MS.
 (mailing address)

description of formations encountered	depth	
	from	to
<u>Clay</u>	<u>0</u>	<u>30</u>
<u>Sand</u>	<u>30</u>	<u>75</u>
<u>Blue Clay</u>	<u>75</u>	<u>125</u>
<u>Shale</u>	<u>125</u>	<u>200</u>
<u>Sandy Shale</u>	<u>200</u>	<u>315</u>
<u>FINE Sand</u>	<u>315</u>	<u>330</u>
<u>Coarse Sand</u>	<u>330</u>	<u>360</u>

WELL LOCATION:
 sec. 30 T. 17 N. R. 8 W. Gr 1
7 miles S-E of Gr 1
 (distance) (direction) (nearest town)

WELL PURPOSE: Home
 (home, irrigation, municipal, industrial)

WELL COMPLETION DATA:

- (1) diameter (inches) 2
- (2) total depth (feet) 360
- (3) static water level (feet) 28 below top of ground.
- (4) casing PVC 350
 (material) (depth)
- _____ if telescope see back.
 (size)
- (5) screen 10 _____
 (length) (depth to top)
- 2' _____
 (size) (material)
- (6) pump 1 10
 (HP) (yield gpm)
- 3hp
 (type power)
- (7) electric log NO
 (yes or no)
- WVA
 (organization running log)
- (8) how well bottom plugged WVA

DRILLERS REMARKS:


DEPT OF NATURAL RESOURCES
 BUREAU OF LAND & WATER RESOURCES

JAN 14 1983

RECEIVED

If well telescopes please
sketch and show depths.

GROUND LEVEL

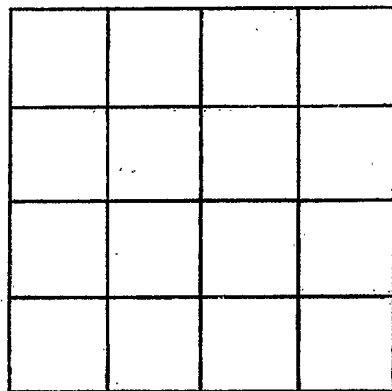

SECTION _____

Please indicate well location X.

ADDITIONAL INFORMATION

If more than one screen,
show locations of each on sketch.