

MISSISSIPPI DEPARTMENT OF NATURAL RESOURCES

Bureau of Land and Water Resources

Southport Mall

P.O. Box 10631

Jackson, Mississippi 39209

WATER WELL DRILLERS LOG

Washington
G 2050
5-10-83

5-10 1983 Schultz Drilling Washington
 date well completed firm name county well located

LANDOWNER: Leon Mays
 Greenville MS

description of formations encountered	depth	
	from	to
CLAY	0	28
SAND	28	50
SAND + Pea Gravel	50	70

(mailing address)
 WELL LOCATION:
 sec. 30-T-17(N) R 8 E
 S 7 miles SE of Greenville
 (distance) (direction) (nearest town)

WELL PURPOSE: HOME
 (home, irrigation, municipal, industrial)

- WELL COMPLETION DATA:
- (1) diameter (inches) 2"
 - (2) total depth (feet) 70'
 - (3) static water level (feet) 20' below top of ground.
 - (4) casing PVC, 60' (material) (depth)
 - (size) if telescope see back.
 - (5) screen 10', 60' (length) (depth to top)
 2" PVC (size) (material)
 - (6) pump X (HP) X (yield gpm)
 X (type power)
 - (7) electric log NO (yes or no)

(organization running log)

(8) how well bottom plugged CAP

DRILLERS REMARKS:


DEPT. OF NATURAL RESOURCES
 BUREAU OF LAND & WATER RESOURCES

JUN - 2 1983

RECEIVED

If well telescopes please sketch and show depths.

GROUND LEVEL

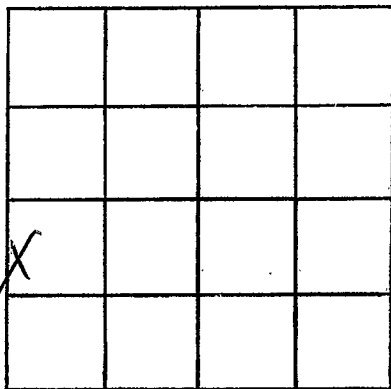

SECTION 30

Please indicate well location X.

ADDITIONAL INFORMATION

If more than one screen,
show locations of each on sketch.