

MISSISSIPPI DEPARTMENT OF NATURAL RESOURCES

Bureau of Land and Water Resources

Southport Mall

P.O. Box 10631

Jackson, Mississippi 39209

WATER WELL DRILLERS LOG

Washington
G 2251
5-11-83

5-11 1983 Schultz Drilling Washington
date well completed firm name county well located

LANDOWNER:
Raymond Pritchett
Greenville MS
(mailing address)

description of formations encountered	from	to
CLAY	0	30
SAND + Pea gravel	30	85
CLAY	85	230
SANDY SHALE	230	350
SAND	350	380

WELL LOCATION:
sec. 30 T. 17 N. R. 8 E. S. 7 W.
7 miles SE of Greenville
(distance) (direction) (nearest town)

WELL PURPOSE: Home
(home, irrigation, municipal, industrial)

- WELL COMPLETION DATA:
- (1) diameter (inches) 2"
 - (2) total depth (feet) 380'
 - (3) static water level (feet) 32' below top of ground.
 - (4) casing PVC 370'
(material) (depth)
 - (size) If telescope see back.
 - (5) screen 10' 370'
(length) (depth to top)
 - 2" PVC
(size) (material)
 - (6) pump 1 99pm
(HP) (yield gpm)
 - ELE.
(type power)
 - (7) electric log NO
(yes or no)
 - (organization running log)
 - (8) how well bottom plugged b/w

DEPT. OF NATURAL RESOURCES
BUREAU OF LAND & WATER RESOURCES


JUN - 2 1983

RECEIVED

DRILLERS REMARKS: B

If well telescopes please
sketch and show depths.

GROUND LEVEL

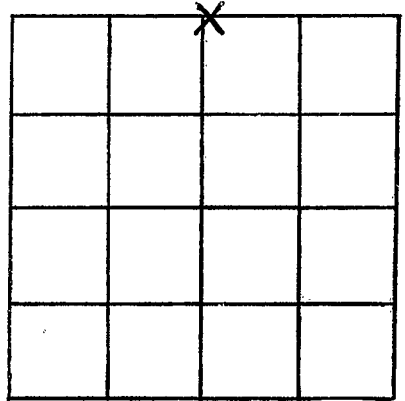

SECTION 30

Please indicate well location X.

ADDITIONAL INFORMATION

If more than one screen,
show locations of each on sketch.