

MISSISSIPPI DEPARTMENT OF NATURAL RESOURCES

Bureau of Land and Water Resources

Southport Mall

P.O. Box 10631

Jackson, Mississippi 39209

WATER WELL DRILLERS LOG

Washington
B 2053

21 Aug 1983 Lambert Drilling Wash
date well completed firm name county well located

| LANDOWNER: | description of formations encountered | from | to |
|---|---------------------------------------|------|-----|
| Payton Bell Greenville, Miss. (mailing address) | | | |
| WELL LOCATION: | | | |
| sec. 12 T. 17 N. R. 8 E. S. 5 6 miles (distance) S of Greenville (direction) of (nearest town) | mixed | 0 | 15 |
| WELL PURPOSE: name (home, irrigation, municipal, industrial) | blue clay | 15 | 65 |
| WELL COMPLETION DATA: | sand | 65 | 80 |
| (1) diameter (inches) 2 | blue clay | 80 | 210 |
| (2) total depth (feet) 510 | Clay & sand | 210 | 410 |
| (3) static water level (feet) 42 below top of ground. | sand light | 410 | 460 |
| (4) casing PVC 500 (material) (depth) | sand | 460 | 510 |
| 2 (size) if telescope see back. | | | |
| (5) screen 10 510-500 (length) (depth to top) | | | |
| 2 PVC (size) (material) | | | |
| (6) pump 1 10 (HP) (yield gpm) | | | |
| elect (type power) | | | |
| (7) electric log (yes or no) | | | |
| (organization running log) | | | |
| (8) how well bottom plugged back press | | | |
| DRILLERS REMARKS: | | | |


DEPT. OF NATURAL RESOURCES
BUREAU OF LAND & WATER RESOURCES

NOV 29 1983

RECEIVED

If well telescopes please sketch and show depths.

GROUND LEVEL

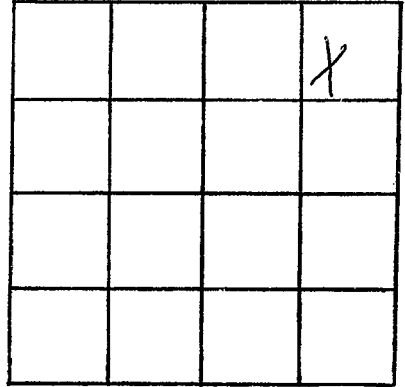

SECTION 12

Please indicate well location X.

ADDITIONAL INFORMATION

If more than one screen,
show locations of each on sketch.