

Washington  
 G 2084

MISSISSIPPI  
 BOARD OF WATER COMMISSIONERS  
 416 North State Street  
 Jackson, Mississippi 39201

WATER WELL DRILLERS LOG

9-6-83 19 Schultz Drilling Washington  
 date well completed firm name county well located

LANDOWNER: Leland Jennings  
 Rt 2.

Greenville MS  
 (mailing address)

WELL LOCATION:

sec. 15 T 17 N R 8 E  
 4 S W of Greenville  
 (distance) (direction) (nearest town)

WELL PURPOSE:  
 (home, irrigation, municipal, industrial)

WELL COMPLETION DATA:

- (1) diameter (inches) 4" X 2"
- (2) total depth (feet) 420'
- (3) static water level (feet) 24' below top of ground.
- (4) casing PVC 400' (material) (depth)
- (size) If telescope see back.
- (5) screen 20' 400' (length) (depth to top)
- 2" PVC (size) (material)
- (6) pump 1hp 19 gpm (HP) (yield gpm)
- E/E (type power)
- (7) electric log NO (yes or no)
- X (organization running log)
- (8) how well bottom plugged b/w

description of formations encountered

from to

CLAY	0	20
SAND + pea gravel	20	90
CLAY	90	120
SANDY clay	120	370
SAND	370	420

DRILLERS REMARKS:



DEPT. OF NATURAL RESOURCES  
 BUREAU OF LAND & WATER RESOURCES

SEP 26 1983

RECEIVED

If well telescopes please sketch and show depths.

GROUND LEVEL

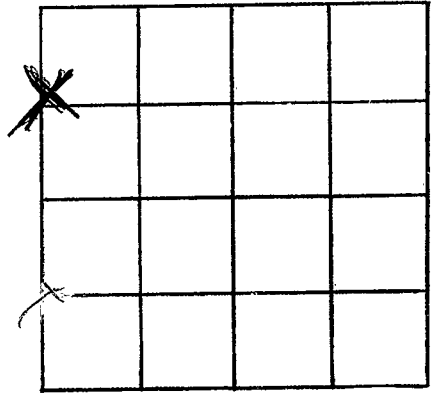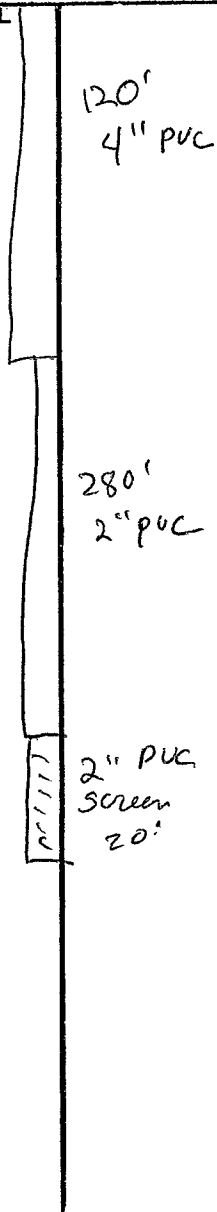

SECTION 5

Please indicate well location X.

ADDITIONAL INFORMATION

If more than one screen,  
show locations of each on sketch.