

MISSISSIPPI DEPARTMENT OF NATURAL RESOURCES

Bureau of Land and Water Resources

Southport Mall

P.O. Box 10631

Jackson, Mississippi 39209

WATER WELL DRILLERS LOG

Washington
G 2055

21 Sept 1983 Lambert Drilling Wash.
date well completed firm name county well located

LANDOWNER:	description of formations encountered	from	to
Jessie Rhodes			
Hwy 82 W Greenville (mailing address)	Mixed	0	25
WELL LOCATION:	Sand	25	45
sec. 15 T 17 N R 8 E 8 miles S/W of Greenville (distance) (direction) (nearest town)	Sand	45	80
WELL PURPOSE: name: (home, irrigation, municipal, industrial)	Red gravel	80	86
WELL COMPLETION DATA:	Clay shell	86	210
(1) diameter (inches) 2	Clay & Sand	210	460
(2) total depth (feet) 510	Sand	460	510
(3) static water level (feet) 51 below above top of ground.			
(4) casing PVC, 500 (material) (depth) (size) if telescope see back.			
(5) screen 10, 510-500 (length) (depth to top) 2 PVC (size) (material)			
(6) pump 1 10 (HP) (yield gpm) elect (type power)			
(7) electric log (yes or no) (organization running log)			
(8) how well bottom plugged back press.			
DRILLERS REMARKS:			


DEPT. OF NATURAL RESOURCES
BUREAU OF LAND & WATER RESOURCES

NOV 29 1983

RECEIVED

If well telescopes please sketch and show depths.

GROUND LEVEL

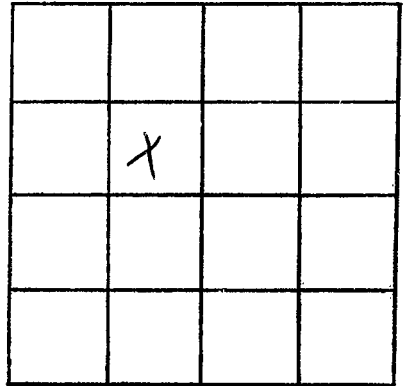

SECTION 15

Please indicate well location X.

ADDITIONAL INFORMATION

If more than one screen,
show locations of each on sketch.