

Washington  
G 2058

MISSISSIPPI DEPARTMENT OF NATURAL RESOURCES  
Bureau of Land and Water Resources  
Southport Mall  
P.O. Box 10631  
Jackson, Mississippi 39209  
WATER WELL DRILLERS LOG

4-23-1984 date well completed  
Schultz Drilling firm name  
Washington county well located

LANDOWNER: DAVID Lee  
Bayou Rd  
Greenville, MS  
(mailing address)

description of formations encountered	from	to
CLAY	0	20
SAND + pea gravel	20	90
CLAY	90	380
SAND	380	480

WELL LOCATION:  
sec. 11 T. 17 N. R. 8 E  
2 miles SW of Greenville  
(distance) (direction) (nearest town)

WELL PURPOSE: Home  
(home, irrigation, municipal, industrial)

- WELL COMPLETION DATA:
- (1) diameter (inches) 4" x 2"
  - (2) total depth (feet) 480'
  - (3) static water level (feet) 28' below top of ground.
  - (4) casing PVC 460' (material), (depth)  
4" x 2" (size) If telescope see back.
  - (5) screen 20' 460' (length), (depth to top)  
2" (size), PVC (material)
  - (6) pump 1HP 20 (HP), (yield gpm)  
ele (type power)
  - (7) electric log No (yes or no)  
X (organization running log)
  - (8) how well bottom plugged Backwas



DEPT. OF NATURAL RESOURCES  
BUREAU OF LAND & WATER RESOURCES

APR 24 1984

RECEIVED

DRILLERS REMARKS:

If well telescopes please sketch and show depths.

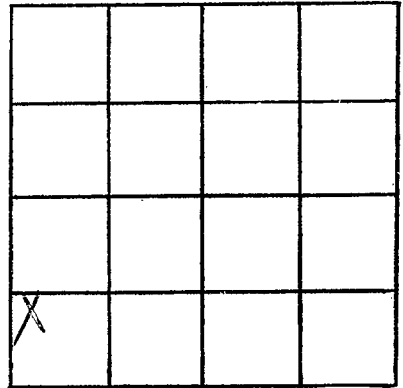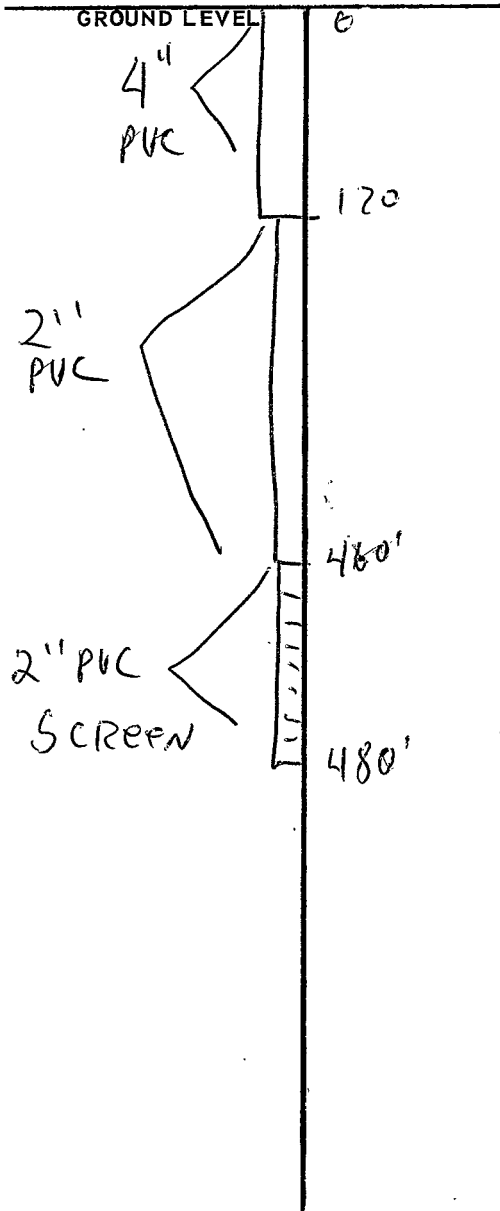

SECTION 11

Please indicate well location X.

ADDITIONAL INFORMATION

Lined area for additional information.

If more than one screen, show locations of each on sketch.