

Washington
G 2059

MISSISSIPPI DEPARTMENT OF NATURAL RESOURCES

Bureau of Land and Water Resources

Southport Mall

P.O. Box 10631

Jackson, Mississippi 39209

WATER WELL DRILLERS LOG

6-22-84
date well completed

Schultz Drilling
firm name

Washington
county well located

LANDOWNER:	description of formations encountered	from	to
EARL VANCE JR.			
Haxton Rd., Greenville (mailing address)	Clay	6	20
	SAND	20	90
	Clay	90	160
WELL LOCATION:	SANDY clay	160	340
sec. 8 T 17 N R 8 E	Clay + SAND	340	400
4 miles S of Greenville (distance) (direction) (nearest town)	S STREAKS		
	Clay	400	420
	SAND	420	460
WELL PURPOSE: Home (home, irrigation, municipal, industrial)			
WELL COMPLETION DATA:			
(1) diameter (inches) 2"			
(2) total depth (feet) 460'			
(3) static water level (feet) 21' below top of ground.			
(4) casing PVC 450' (material) (depth)			
(5) screen 10' 450' (length) (depth to top)			
2" PVC (size) (material)			
(6) pump 1 10 (HP) (yield gpm)			
ele (type power)			
(7) electric log No (yes or no)			
X (organization running log)			
(8) how well bottom plugged b/w			
DRILLERS REMARKS:			


DEPT. OF NATURAL RESOURCES
BUREAU OF LAND & WATER RESOURCES

JUN 25 1984

RECEIVED

If well telescopes please sketch and show depths.

GROUND LEVEL

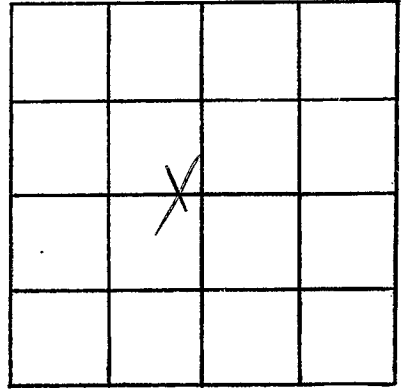

SECTION 8

Please indicate well location X.

ADDITIONAL INFORMATION

If more than one screen,
show locations of each on sketch.