

Washington
G 2000

MISSISSIPPI DEPARTMENT OF NATURAL RESOURCES
Bureau of Land and Water Resources
Southport Mall
P.O. Box 10631
Jackson, Mississippi 39209
WATER WELL DRILLERS LOG

22 June 1984 Lambert Drilling Wash
date well completed firm name county well located

LANDOWNER:	description of formations encountered	from	to
R. Clark			
Horton Rd Greenville (mailing address)	Clay	0	30
WELL LOCATION:	Sand	30	65
sec. 8 T 17 N R 8 E 5 miles S/E of Greenville (distance) (direction) (nearest town)	Clay blue	65	120
WELL PURPOSE: none (home, irrigation, municipal, industrial)	Clay & Sand	120	230
WELL COMPLETION DATA:	Sand	230	250
(1) diameter (inches) 2	Sand good	250	300
(2) total depth (feet) 300			
(3) static water level (feet) 51 below top of ground.			
(4) casing PVC, 280 (material) (depth) 2 (size) if telescope see back.			
(5) screen 20, 300-280 (length) (depth to top) 2, PVC (size) (material)			
(6) pump 1, 10 (HP) (yield gpm) elect (type power)			
(7) electric log _____ (yes or no) (organization running log)			
(8) how well bottom plugged back PRESS.			
DRILLERS REMARKS:			


DEPT. OF NATURAL RESOURCES
BUREAU OF LAND & WATER RESOURCES

AUG 15 1984

RECEIVED

If well telescopes please
sketch and show depths.

GROUND LEVEL

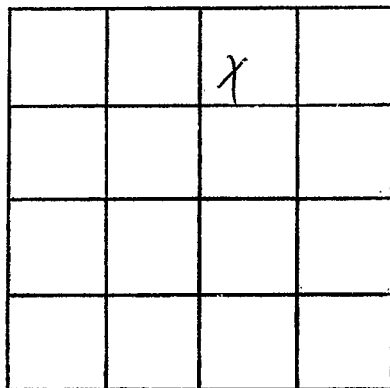

SECTION 8

Please indicate well location X.

ADDITIONAL INFORMATION

If more than one screen,
show locations of each on sketch.