

MISSISSIPPI DEPARTMENT OF NATURAL RESOURCES

Bureau of Land and Water Resources

Southport Mall

P.O. Box 10631

Jackson, Mississippi 39209

WATER WELL DRILLERS LOG

Washington
 ←
2005

7-15 1985 Schultz Drilling Washington
 date well completed firm name county well located

LANDOWNER:	description of formations encountered	from	to
MARC Curtis Leland MS (mailing address)			
WELL LOCATION: sec. <u>35</u> T. <u>17</u> N R. <u>8</u> E S W <u>6</u> miles <u>S</u> of <u>Greenville</u> (distance) (direction) (nearest town)			
WELL PURPOSE: <u>HOME</u> (home, irrigation, municipal, industrial)			
WELL COMPLETION DATA:			
(1) diameter (inches) <u>2"</u>			
(2) total depth (feet) <u>410'</u>			
(3) static water level (feet) <u>35'</u> below above top of ground.			
(4) casing <u>PVC</u> <u>400'</u> (material) (depth) <u>2"</u> (size) if telescope see back.			
(5) screen <u>10'</u> <u>400'</u> (length) (depth to top) <u>2"</u> <u>PVC</u> (size) (material)			
(6) pump <u>1</u> <u>10</u> (HP) (yield gpm) <u>ele</u> (type power)			
(7) electric log <u>NO</u> (yes or no) <u>X</u> (organization running log)			
(8) how well bottom plugged <u>b/w</u>			


RECEIVED
 DEC 3 - 1995

Department of Natural Resources
 Bureau of Land & Water Resources

DRILLERS REMARKS:

If well telescopes please sketch and show depths.

GROUND LEVEL

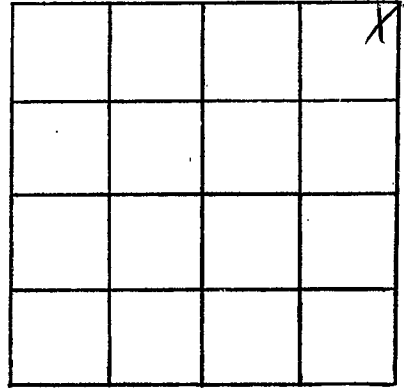

SECTION 36

Please indicate well location X.

ADDITIONAL INFORMATION

If more than one screen,
show locations of each on sketch.