

MISSISSIPPI DEPARTMENT OF NATURAL RESOURCES

Bureau of Land and Water Resources

Southport Mall

P.O. Box 10631

Jackson, Mississippi 39209

WATER WELL DRILLERS LOG

WASHINGTON
G
2008

8 Jan 1986 date well completed Lambert Drilling firm name Wash county well located

LANDOWNER:	description of formations encountered	from	to
Henry Armstrong Greenville, Miss. (mailing address)			
WELL LOCATION:	Sand per gravel	30	96
sec. 17 T. 17 N. R. 9 E 8 miles S of Greenville (distance) (direction) (nearest town)	Clay shell	96	210
WELL PURPOSE: name (home, irrigation, municipal, industrial)	Clay st sand	210	310
WELL COMPLETION DATA:	fine sand	310	460
(1) diameter (inches) 4x2	Sand	460	510
(2) total depth (feet) 510			
(3) static water level (feet) 52 below top of ground.			
(4) casing PVC 480 (material) (depth) 4x2 (size) if telescope see back.			
(5) screen 30 510-480 (length) (depth to top) 2 (size) PVC (material)			
(6) pump 1 20 (HP) (yield gpm) elect (type power)			
(7) electric log <input checked="" type="checkbox"/> (yes or no)			
(organization running log)			
(8) how well bottom plugged back pass.			
DRILLERS REMARKS:			

RECEIVED

MAR 11 1986

Department of Natural Resources
Bureau of Land & Water Resources

If well telescopes please sketch and show depths.

GROUND LEVEL

140


4''

180

2''

510

2'' 5cv.

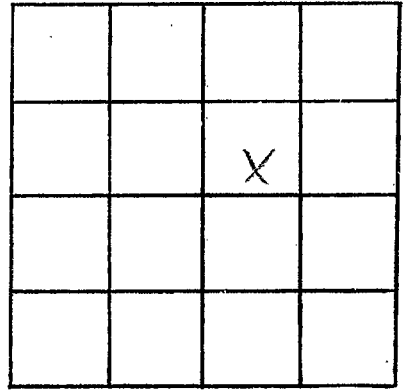

SECTION 17

Please indicate well location X.

ADDITIONAL INFORMATION

If more than one screen,
show locations of each on sketch.