

WASHINGTON
G2069

MISSISSIPPI DEPARTMENT OF NATURAL RESOURCES
Bureau of Land and Water Resources
Southport Mall
P.O. Box 10631
Jackson, Mississippi 39209
WATER WELL DRILLERS LOG

3-24-86
date well completed

Schultz Drilling
firm name

Washington
county well located

LANDOWNER: Wayne Brimer
40 Lake Lee Rd
Greenville, Ms
(mailing address)

description of formations encountered	from	to
CLAY	0	20
SAND	20	95
CLAY	95	160
SHALE	160	340
FINE SAND	340	360
SAND	360	405

WELL LOCATION:
sec. 1 T. 17 N. R. 8 E. S. 5
6 miles S of Greenville
(distance) (direction) (nearest town)


WELL PURPOSE: HOME
(home, irrigation, municipal, industrial)

- WELL COMPLETION DATA:
- (1) diameter (inches) 2"
 - (2) total depth (feet) 405'
 - (3) static water level (feet) 28' below top of ground.
 - (4) casing PVC, 395'
(material) (depth)
 - If telescope see back.
(size)
 - (5) screen 10", 395'
(length) (depth to top)
 - 2", PVC
(size) (material)
 - (6) pump 1, 10
(HP) (yield gpm)
 - EIE
(type power)
 - (7) electric log No
(yes or no)
 - X
(organization running log)
 - (8) how well bottom plugged b/w

DRILLERS REMARKS:

If well telescopes please sketch and show depths.

GROUND LEVEL

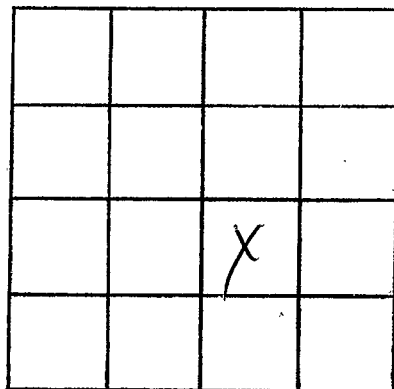

SECTION 1

Please indicate well location X.

ADDITIONAL INFORMATION

If more than one screen,
show locations of each on sketch.