

MISSISSIPPI DEPARTMENT OF NATURAL RESOURCES

Bureau of Land and Water Resources

Southport Mall

P.O. Box 10631

Jackson, Mississippi 39209

WATER WELL DRILLERS LOG

WASHINGTON  
 Cr  
 2070

5-12-86 19 date well completed Schultz Drilling firm name Washington county well located

LANDOWNER: RONNIE SMITH  
LAKE LEE ROAD  
GREENVILLE, MS  
 (mailing address)

description of formations encountered	from	to
CLAY	0	30
SAND	30	115
SHALE	115	330
Silty SAND	330	375
SAND	375	420

WELL LOCATION:  
 sec. 1 T. 17 S. R. 9 E.  
4 miles S of GREENVILLE  
 (distance) (direction) (nearest town)

WELL PURPOSE: HOME  
 (home, irrigation, municipal, industrial)

WELL COMPLETION DATA:



(1) diameter (inches) 4" X 2"  
 (2) total depth (feet) 420'  
 (3) static water level (feet) 31 below/above top of ground.  
 (4) casing PVC 400'  
 (material) (depth)  
 (size) if telescope see back.  
 (5) screen 20' 400'  
 (length) (depth to top)  
2" PVC  
 (size) (material)  
 (6) pump 1 20  
 (HP) (yield gpm)  
etc  
 (type power)  
 (7) electric log NO  
 (yes or no)  
 (organization running log)  
 (8) how well bottom plugged b/w

RECEIVED  
 MAY 29 1986

Department of Natural Resources  
 Bureau of Land & Water Resources

DRILLERS REMARKS:

If well telescopes please sketch and show depths.

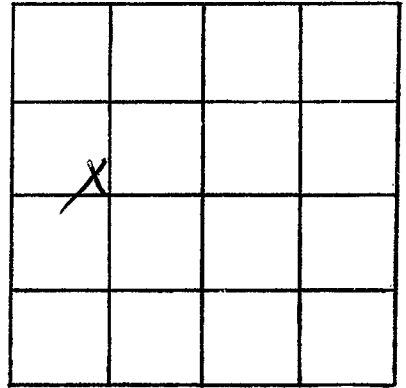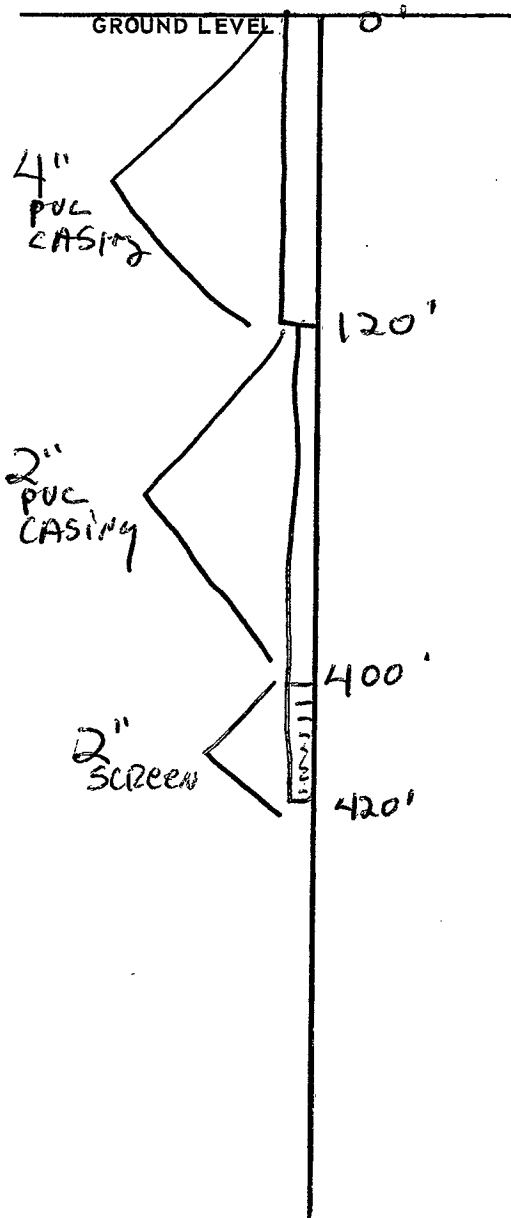

SECTION 1

Please indicate well location X.

ADDITIONAL INFORMATION

If more than one screen, show locations of each on sketch.