

WASHINGTON
G 2001

MISSISSIPPI DEPARTMENT OF NATURAL RESOURCES
Bureau of Land and Water Resources
Southport Mall
P.O. Box 10631
Jackson, Mississippi 39209
WATER WELL DRILLERS LOG

8-18, 1986 date well completed
Schultz Drilling firm name
WASHINGTON county well located


LANDOWNER: Delta Net + Twine
Hwy 1 South
Greenville, MS
(mailing address)

| description of formations encountered | from | to |
|---------------------------------------|------|-----|
| | CLAY | 0 |
| SAND | 30 | 82 |
| SHALE | 82 | 360 |
| SAND | 360 | 390 |

WELL LOCATION:
sec. 22 T. 11 N. R. 8 E. S. 4
4 miles S of Greenville
(distance) (direction) (nearest town)

WELL PURPOSE: INDUSTRIAL
(home, irrigation, municipal, industrial)

- WELL COMPLETION DATA:
- (1) diameter (inches) 2"
 - (2) total depth (feet) 390'
 - (3) static water level (feet) 36' below above top of ground.
 - (4) casing PVC 380'
(material) (depth)
 - (5) screen 10' 380'
(length) (depth to top)
2" PVC
(size) (material)
 - (6) pump 1 10
(HP) (yield gpm)
ele
(type power)
 - (7) electric log NO
(yes or no)
K
(organization running log)
 - (8) how well bottom plugged b/w

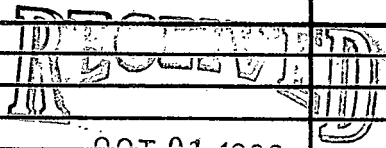


OCT 01 1986

DRILLERS REMARKS:

Department of Natural Resources
Bureau of Land & Water Resources

If well telescopes please sketch and show depths.

GROUND LEVEL

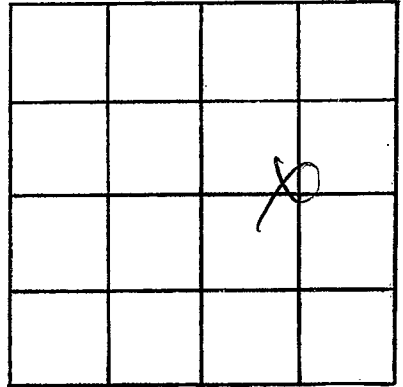

SECTION

22

Please indicate well location X.

ADDITIONAL INFORMATION

If more than one screen,
show locations of each on sketch.