

WASHINGTON  
G 2072

MISSISSIPPI DEPARTMENT OF NATURAL RESOURCES  
Bureau of Land and Water Resources  
Southport Mall  
P.O. Box 10631  
Jackson, Mississippi 39209  
WATER WELL DRILLERS LOG

8-19, 1986 Schultz Drilling Washington  
date well completed firm name county well located

LANDOWNER: Charles Fraizer  
Main Street Ext.  
Greenville, MS  
(mailing address)

description of formations encountered	from to	
CLAY	0	150
SHALE	150	405
SAND	405	480

WELL LOCATION:  
sec. R 17 N S R 8 E  
4 miles S of Greenville  
(distance) (direction) (nearest town)

WELL PURPOSE: Home  
(home, irrigation, municipal, industrial)

- WELL COMPLETION DATA:
- diameter (inches) 2"
  - total depth (feet) 480
  - static water level (feet) 49' below above top of ground.
  - casing PVC 470'  
(material) (depth)  
2" if telescope see back.  
(size)
  - screen 10" 470'  
(length) (depth to top)  
2" PVC  
(size) (material)
  - pump 1 10  
(HP) (yield gpm)  
elc  
(type power)
  - electric log no  
(yes or no)  
✓  
(organization running log)
  - how well bottom plugged b/w


RECEIVED  
OCT 01 1986

Department of Natural Resources  
Bureau of Land & Water Resources

DRILLERS REMARKS:

If well telescopes please sketch and show depths.

GROUND LEVEL

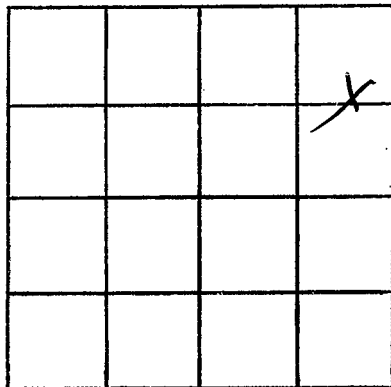

SECTION

12

Please indicate well location X.

ADDITIONAL INFORMATION

If more than one screen,  
show locations of each on sketch.