

MISSISSIPPI DEPARTMENT OF NATURAL RESOURCES

Bureau of Land and Water Resources

Southport Mall

P.O. Box 10631

Jackson, Mississippi 39209

WATER WELL DRILLERS LOG

Washington
G 2073

24 Aug 1984 hambert Wash
date well completed firm name county well located

LANDOWNER:
Mrs. Kee
Wayside, Miss.
(mailing address)

WELL LOCATION:
sec. 6 T. 16 N. R. 9 E. S. 8 W.
4 miles E of Wayside
(distance) (direction) (nearest town)

WELL PURPOSE: home
(home, irrigation, municipal, industrial)

WELL COMPLETION DATA:

- (1) diameter (inches) 2"
- (2) total depth (feet) 405
- (3) static water level (feet) 56 below above top of ground.
- (4) casing PVC, 385'
(material) (depth)
2" if telescope see back.
(size)
- (5) screen 20, 405-485
(length) (depth to top)
2, PVC
(size) (material)
- (6) pump 1, 16
(HP) (yield gpm)
elect
(type power)
- (7) electric log
(yes or no)

(organization running log)
- (8) how well bottom plugged Back Press

description of formations encountered	from	to
<u>Mixed</u>	<u>0</u>	<u>10</u>
<u>Clay</u>	<u>10</u>	<u>30</u>
<u>Sand</u>	<u>30</u>	<u>60</u>
<u>As gravel</u>	<u>60</u>	<u>79</u>
<u>Clay chff</u>	<u>79</u>	<u>105</u>
<u>Clay</u>	<u>105</u>	<u>180</u>
<u>Clay - 5' Sand</u>	<u>180</u>	<u>300</u>
<u>Sand</u>	<u>300</u>	<u>405</u>

RECEIVED


NOV 7 1986

Department of Natural Resources
Bureau of Land & Water Resources

DRILLERS REMARKS:

If well telescopes please sketch and show depths.

GROUND LEVEL

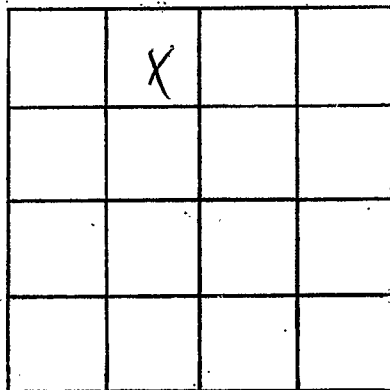

SECTION 60

Please indicate well location X.

ADDITIONAL INFORMATION

If more than one screen, show locations of each on sketch.