

MISSISSIPPI DEPARTMENT OF NATURAL RESOURCES

Bureau of Land and Water Resources

Southport Mall

P.O. Box 10631

Jackson, Mississippi 39209

WATER WELL DRILLERS LOG

WASHINGTON  
G 2075

24 Sept 1986 Lambert Drilling Wash  
date well completed firm name county well located

LANDOWNER:	description of formations encountered	from	to
Bill Bogkin Greenville, Miss. (mailing address)			
WELL LOCATION: sec. 14 T 17 N R 9 E 4 miles S of Greenville (distance) (direction) (nearest town)	Clay	0	30
WELL PURPOSE: home (home, irrigation, municipal, industrial)	sand	30	75
WELL COMPLETION DATA: (1) diameter (inches) 4x2	Pea gravel	75	98
(2) total depth (feet) 495	Clay	98	205
(3) static water level (feet) 52 below top of ground.	Clay st sand	205	380
(4) casing PVC, 465 (material) (depth)	Sand fine sand	380	430
4x2 (size) If telescope see back.	sand	430	500
(5) screen 30, 495-465 (length) (depth to top)			
2, PVC (size) (material)			
(6) pump 1, 20 (HP) (yield gpm)			
elect (type power)			
(7) electric log no (yes or no)			
(organization running log)			
(8) how well bottom plugged back			
DRILLERS REMARKS:			

RECEIVED

FEB 18 1986

Department of Natural Resources  
Bureau of Land & Water Resources


If well telescopes please sketch and show depths.

GROUND LEVEL

140 4"

#65 2"

495 2" scr.

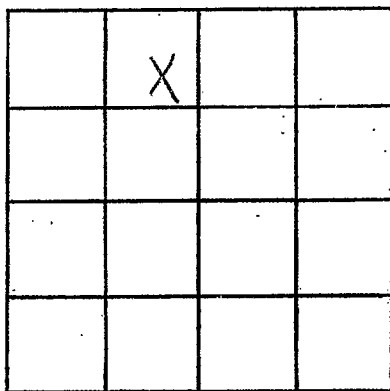

SECTION 14

Please indicate well location X.

ADDITIONAL INFORMATION

If more than one screen, show locations of each on sketch.