

WASHINGTON
G 2074

MISSISSIPPI DEPARTMENT OF NATURAL RESOURCES
Bureau of Land and Water Resources
Southport Mall
P.O. Box 10631
Jackson, Mississippi 39209
WATER WELL DRILLERS LOG

26 Oct 1986 Lambert Drilling Wash
date well completed firm name county well located

LANDOWNER:
Larry McWhorter
Greenville Miss
(mailing address)

WELL LOCATION:
sec. 14 T 17 N R. 9 E
4 miles S of Greenville
(distance) (direction) (nearest town)

WELL PURPOSE: home
(home, irrigation, municipal, industrial)

- WELL COMPLETION DATA:
- (1) diameter (inches) 4x2
 - (2) total depth (feet) 490
 - (3) static water level (feet) 52 below top of ground.
 - (4) casing PVC, 460, (material) (depth)
4x2 If telescope see back. (size)
 - (5) screen 30, 460-490 (length) (depth to top)
4x2, PVC (size) (material)
 - (6) pump 1, 20 (HP) (yield gpm)
elect (type power)
 - (7) electric log no (yes or no)
 - (organization running log)
 - (8) how well bottom plugged
Back press

description of formations encountered	from	to
Clay	0	15
Sand	15	60
pea gravel	60	118
blue shell	118	160
Clay & sand	160	300
Sand. light	300	450
Sand.	450	490

RECEIVED

FEB 18 1987

Department of Natural Resources
Bureau of Land & Water Resources

DRILLERS REMARKS:

If well telescopes please sketch and show depths.


GROUND LEVEL

140 4"

460 2 1/2"

490 2 1/2" Scr.

If more than one screen,
show locations of each on sketch.

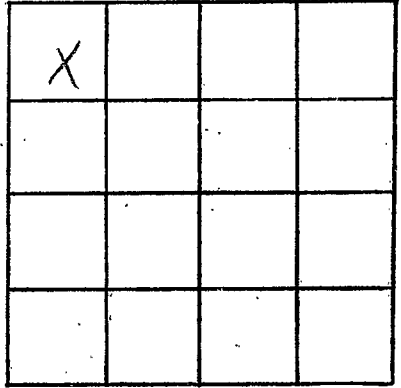

SECTION 14

Please indicate well location X.

ADDITIONAL INFORMATION

Lined area for additional information.