

MISSISSIPPI DEPARTMENT OF NATURAL RESOURCES
 Bureau of Land and Water Resources
 Southport Mall
 P.O. Box 10631
 Jackson, Mississippi 39209
WATER WELL DRILLERS LOG

W.A. HARNOLD
G 2078

29 Jan 1987 Lambert Drilling wash
 date well completed firm name county well located

LANDOWNER:
Lonny Braxton
Greenville, Miss.
 (mailing address)

WELL LOCATION:
 sec. 18 T. 17 N. R. 9 E
7 miles SW of Greenville
 (distance) (direction) (nearest town)

WELL PURPOSE: home
 (home, irrigation, municipal, industrial)

WELL COMPLETION DATA:

- (1) diameter (inches) 2
- (2) total depth (feet) 525
- (3) static water level (feet) 46 below above top of ground.
- (4) casing PVC, 505,
 (material) (depth)
2 if telescope see back.
 (size)
- (5) screen 20, 525-505
 (length) (depth to top)
2, PVC
 (size) (material)
- (6) pump 1 10
 (HP) (yield gpm)
elect
 (type power)
- (7) electric log no
 (yes or no)
 (organization running log)
- (8) how well bottom plugged
back plug

description of formations encountered	from	to
Clay	0	15
Sand pea gravel	15	85
Clay	85	200
Several ft clay	200	480
Sand	480	525

RECEIVED
 FEB 18 1987

Department of Natural Resources
 Bureau of Land & Water Resources


DRILLERS REMARKS:

If well telescopes please sketch and show depths.

GROUND LEVEL

~~140 4-11~~

~~505 2~~

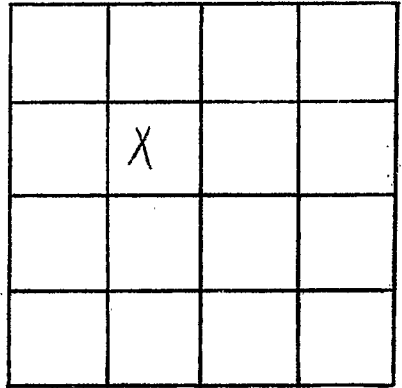

SECTION 15

Please indicate well location X.

ADDITIONAL INFORMATION

If more than one screen, show locations of each on sketch.