

MISSISSIPPI DEPARTMENT OF NATURAL RESOURCES

Bureau of Land and Water Resources

Southport Mall

P.O. Box 10631

Jackson, Mississippi 39209

WATER WELL DRILLERS LOG

Washington  
G 209A

3-29 1987 Schultz Drilling Washington  
 date well completed firm name county well located

LANDOWNER: Percy Pearl  
Guerton Rd  
Greenville, MS  
 (mailing address)

description of formations encountered	from	to
	<u>CLAY</u>	<u>0</u>
<u>SAND</u>	<u>20</u>	<u>60</u>
<u>SAND + gravel</u>	<u>60</u>	<u>80</u>

WELL LOCATION:  
 sec. 18 T. 17 N. R. 9 E  
5 miles S of Greenville  
 (distance) (direction) (nearest town)

WELL PURPOSE: Home  
 (home, irrigation, municipal, industrial)

- WELL COMPLETION DATA:
- (1) diameter (inches) 2"
  - (2) total depth (feet) 80'
  - (3) static water level (feet) 29' below top of ground
  - (4) casing PVC 70'  
 (material) (depth)  
 (size) If telescope see back.
  - (5) screen 10' 70'  
 (length) (depth to top)  
2" PVC  
 (size) (material)
  - (6) pump 1 10  
 (HP) (yield gpm)  
ele  
 (type power)
  - (7) electric log No  
 (yes or no)  
X  
 (organization/running log)
  - (8) how well bottom plugged b/w

**RECEIVED**


JUL 3 1987

Department of Natural Resources  
 Bureau of Land & Water Resources

DRILLERS REMARKS:

If well telescopes please  
sketch and show depths.

GROUND LEVEL

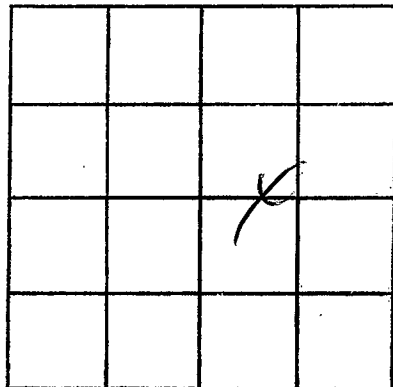

SECTION 18

Please indicate well location X.

ADDITIONAL INFORMATION

If more than one screen,  
show locations of each on sketch.