

Washington
G 2080

MISSISSIPPI DEPARTMENT OF NATURAL RESOURCES
 Bureau of Land and Water Resources
 Southport Mall
 P.O. Box 10631
 Jackson, Mississippi 39209
WATER WELL DRILLERS LOG

5-4 1987 Schultz Drilling Washington
 date well completed firm name county well located

LANDOWNER: George Krine
Redmond Rd
Greenville, MS
 (mailing address)

description of formations encountered	from	to

WELL LOCATION:
 sec. 17 T. 17 N. R. 9 E.
2 miles S. of Greenville
 (distance) (direction) (nearest town)

WELL PURPOSE: Home
 (home, irrigation, municipal, industrial)

WELL COMPLETION DATA:

- (1) diameter (inches) 4" x 2"
- (2) total depth (feet) 460
- (3) static water level (feet) 29' below above top of ground.
- (4) casing PVC 440'
 (material) (depth)
 (size) if telescope see back.
- (5) screen 20' 440'
 (length) (depth to top)
2" PVC
 (size) (material)
- (6) pump 1 20
 (HP) (yield gpm)
ele
 (type power)
- (7) electric log No
 (yes or no)
X
 (organization running log)
- (8) how well bottom plugged b/w



DRILLERS REMARKS:

RECEIVED

JUL 3 1987

Department of Natural Resources
 Bureau of Land & Water Resources

If well telescopes please sketch and show depths.

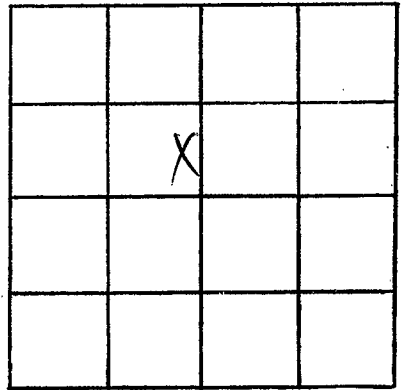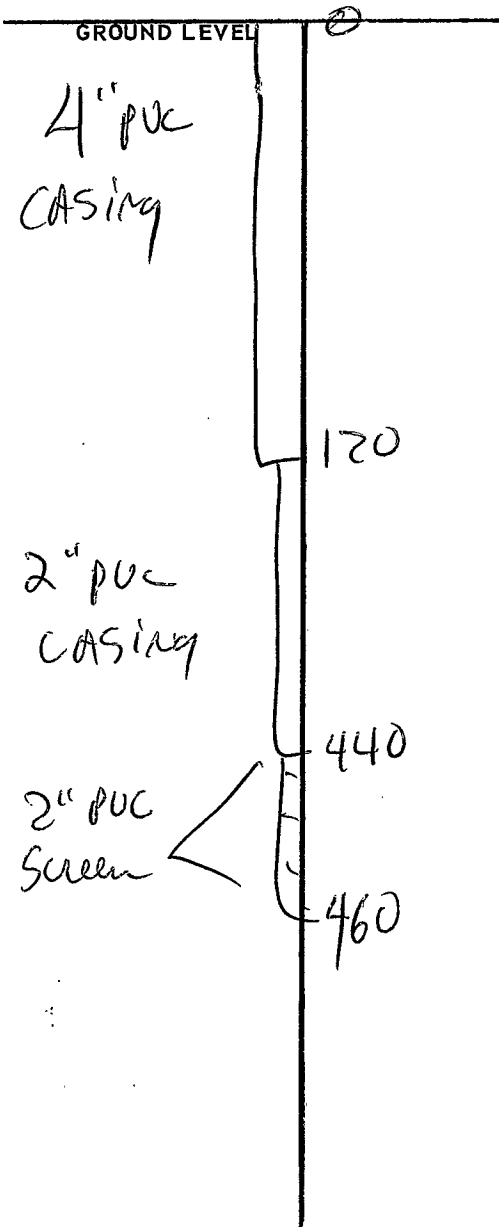

SECTION 19

Please indicate well location X.

ADDITIONAL INFORMATION

Multiple horizontal lines for additional information.

If more than one screen, show locations of each on sketch.