

MISSISSIPPI DEPARTMENT OF NATURAL RESOURCES

Bureau of Land and Water Resources

Southport Mall

P.O. Box 10631

Jackson, Mississippi 39209

WATER WELL DRILLERS LOG

WASHINGTON
G 2081

9-8-87 19 date well completed
Schultz Drilling firm name
Washington county well located

LANDOWNER: Hank BURDINE

description of formations encountered

from

to

P.O. Box 896

Greenville - Mo.
(mailing address)

CLAY

0

36

SAND

30

72

CLAY

72

240

SAND

240

320

SAND

320

440

SAND

440

500

WELL LOCATION:

sec. 25 T. 17N R. 8 E
4 S S of Greenville
(distance) miles (direction) (nearest town)

WELL PURPOSE: Blues Festival Site
(home, irrigation, municipal, industrial)

WELL COMPLETION DATA:

- (1) diameter (inches) 4" X 2"
- (2) total depth (feet) 500'
- (3) static water level (feet) 35' below top of ground.
- (4) casing PVC, 480' (material), (depth)

if telescope see back.

- (5) screen 20' 480' (length), (depth to top)

2" PVC (size), (material)


- (6) pump 1 20 (HP), (yield gpm)

ele (type power)

- (7) electric log NO (yes or no)

X (organization running log)

- (8) how well bottom plugged b/w

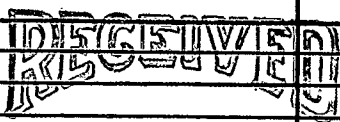


OCT 05 1987

Department of Natural Resources
Bureau of Land & Water Resources

DRILLERS REMARKS:

If well telescopes please sketch and show depths.

GROUND LEVEL

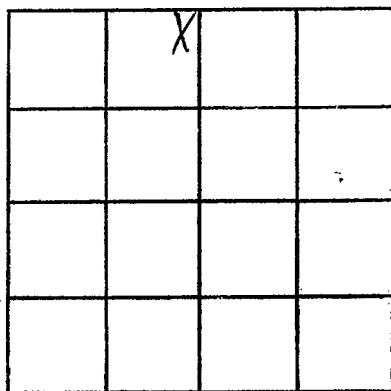

SECTION 25

Please indicate well location X.

ADDITIONAL INFORMATION

If more than one screen, show locations of each on sketch.