

MISSISSIPPI DEPARTMENT OF NATURAL RESOURCES

Bureau of Land and Water Resources

Southport Mall

P.O. Box 10631

Jackson, Mississippi 39209

WATER WELL DRILLERS LOG

Washington
G 2083

8-27-87, 19 Schultz Drilling firm name Washington county well located

LANDOWNER: Miles John
main Extenshal
Greenville, Mo.
 (mailing address)

description of formations encountered	from	to
	CLAY	0
SAND	40	78
CLAY	78	360
SAND	360	420

WELL LOCATION:
 sec. 25 T. 17 N R. 8 E
5 S 5 S W
5 miles (distance) S (direction) of Greenville (nearest town)

WELL PURPOSE: Home
 (~~home~~, irrigation, municipal, industrial)

- WELL COMPLETION DATA:
- (1) diameter (inches) 2"
 - (2) total depth (feet) 420'
 - (3) static water level (feet) 33' below above top of ground.
 - (4) casing PVC 400'
 (material) (depth)
2"
 (size) if telescope see back.
 - (5) screen 10' 400'
 (length) (depth to top)
2" PVC
 (size) (material)
 - (6) pump 1 10
 (HP) (yield gpm)
ele
 (type power)
 - (7) electric log NO
 (yes or no)
X
 (organization running log)
 - (8) how well bottom plugged b/w

RECEIVED


OCT 28 1987

Department of Natural Resources
 Bureau of Land & Water Resources

DRILLERS REMARKS:

If well telescopes please sketch and show depths.

GROUND LEVEL

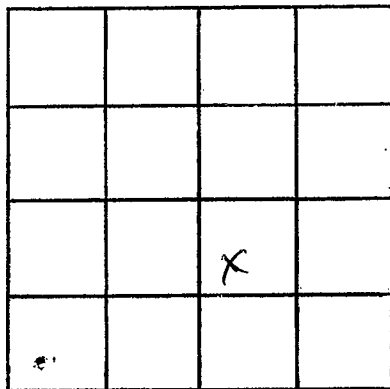

SECTION 25.

Please indicate well location X.

ADDITIONAL INFORMATION

If more than one screen,
show locations of each on sketch.