

Washington  
G 2084

MISSISSIPPI DEPARTMENT OF NATURAL RESOURCES  
Bureau of Land and Water Resources  
Southport Mall  
P.O. Box 10631  
Jackson, Mississippi 39209

WATER WELL DRILLERS LOG

9-22 1987 date well completed  
Schultz Drilling firm name  
Washington county well located

LANDOWNER: MARK Holley  
Rt 1. Box 271  
Greenville MS  
(mailing address)

description of formations encountered	from	to
	SANDY TOPSOIL	0
SAND	10	60
SAND + GRAVEL	60	100

WELL LOCATION:  
sec. 5 T 17 N R 9 E  
3 miles W of Greenville  
(distance) (direction) (nearest town)

WELL PURPOSE: PERCOLATION  
(home, irrigation, municipal, industrial)

- WELL COMPLETION DATA:
- (1) diameter (inches) 4"
  - (2) total depth (feet) 100'
  - (3) static water level (feet) 31' below above top of ground.
  - (4) casing PVC 70'  
(material) (depth)
  - if telescope see back.  
(size)
  - (5) screen 30' 70'  
4" (length) PVC (depth to top)  
(size) (material)
  - (6) pump 3 80  
(HP) (yield gpm)  
sk (type power)
  - (7) electric log NO  
(yes or no)  
Y  
(organization running log)
  - (8) how well bottom plugged CRP


RECEIVED  
OCT 28 1987

Department of Natural Resources  
Bureau of Land & Water Resources

DRILLERS REMARKS:

If well telescopes please sketch and show depths.

GROUND LEVEL

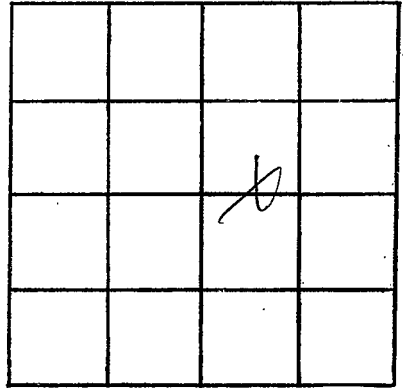

SECTION 15

Please indicate well location X.

ADDITIONAL INFORMATION

If more than one screen,  
show locations of each on sketch.