

WASHINGTON
GT 2085

MISSISSIPPI DEPARTMENT OF NATURAL RESOURCES
Bureau of Land and Water Resources
Southport Mall
P.O. Box 10631
Jackson, Mississippi 39209
WATER WELL DRILLERS LOG

11 aug 1987 Lambert Drilling Wash
date well completed firm name county well located

LANDOWNER:
David Vickers
Greenville, Miss.
(mailing address)

WELL LOCATION:
sec. 20 T. 17 N. R. 9 E. S. 5 W.
8 miles S/W of Greenville
(distance) (direction) (nearest town)

WELL PURPOSE: none
(home, irrigation, municipal, industrial)

WELL COMPLETION DATA:
(1) diameter (inches) 4 1/2
(2) total depth (feet) 505
(3) static water level (feet) 38 below above top of ground.
(4) casing PVC, 475,
(material) (depth)
4 1/2 if telescope see back.
(size)
(5) screen 30, 505-475
(length) (depth to top)
2 1/2, PVC
(size) (material)
(6) pump 1 20
(HP) (yield gpm)
elect
(type power)
(7) electric log no
(yes or no)
(organization running log)

(8) how well bottom plugged back press

DRILLERS REMARKS:

description of formations encountered	from	to
<u>Sand.</u>	<u>0</u>	<u>15</u>
<u>Clay</u>	<u>15</u>	<u>18</u>
<u>Sand.</u>	<u>18</u>	<u>80</u>
<u>pea gravel</u>	<u>80</u>	<u>90</u>
<u>Clay</u>	<u>90</u>	<u>150</u>
<u>Clay st sand.</u>	<u>150</u>	<u>293</u>
<u>rock.</u>	<u>293</u>	<u>295</u>
<u>Small Pine.</u>	<u>295</u>	<u>460</u>
<u>Sand.</u>	<u>460</u>	<u>505</u>

RECEIVED

NOV 25 1987

Department of Natural Resources
Bureau of Land & Water Resources


If well telescopes please sketch and show depths.

GROUND LEVEL

140 4 11

475 2 11

505 2 11 84'

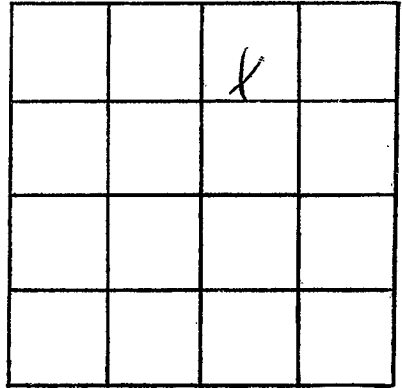

SECTION 20

Please indicate well location X.

ADDITIONAL INFORMATION

If more than one screen, show locations of each on sketch.