

MISSISSIPPI DEPARTMENT OF NATURAL RESOURCES

Bureau of Land and Water Resources

Southport Mall

P.O. Box 10631

Jackson, Mississippi 39209

WATER WELL DRILLERS LOG

W. A. VETON
G 2086

8 July 1987 Lambert Drilling Wash
date well completed firm name county well located

LANDOWNER:	description of formations encountered	from	to
<u>D. Thomas</u>			
<u>Wellmont Rd - Greenville.</u> (mailing address)	<u>Clay</u>	<u>0</u>	<u>30</u>
WELL LOCATION:	<u>sand</u>	<u>30</u>	<u>45</u>
sec. <u>29</u> T <u>17</u> N R <u>8</u> E <u>10</u> miles <u>S/E</u> of <u>Greenville</u> (distance) (direction) (nearest town)	<u>pea gravel</u>	<u>45</u>	<u>89</u>
WELL PURPOSE: <u>none</u> (home, irrigation, municipal, industrial)	<u>Clay</u>	<u>89</u>	<u>270</u>
WELL COMPLETION DATA:	<u>sand & clay</u>	<u>270</u>	<u>410</u>
(1) diameter (inches) <u>4 1/2</u>	<u>sand</u>	<u>410</u>	<u>460</u>
(2) total depth (feet) <u>460</u>			
(3) static water level (feet) <u>48</u> below above top of ground.			
(4) casing <u>PVC</u> , <u>430</u> , (material) (depth) <u>4 1/2</u> if telescope see back. (size)			
(5) screen <u>30</u> , <u>460-430</u> (length) (depth to top) <u>2"</u> , <u>PVC</u> (size) (material)			
(6) pump <u>1</u> , <u>20</u> (HP) (yield gpm) <u>elect</u> (type power)			
(7) electric log <u>no</u> (yes or no) (organization running log)			
(8) how well bottom plugged: <u>back pass.</u>			
DRILLERS REMARKS:			

RECEIVED

NOV 25 1987

Department of Natural Resources
Bureau of Land & Water Resources


If well telescopes please sketch and show depths.

GROUND LEVEL

140 4''

430 2''

460 2'' 5d.

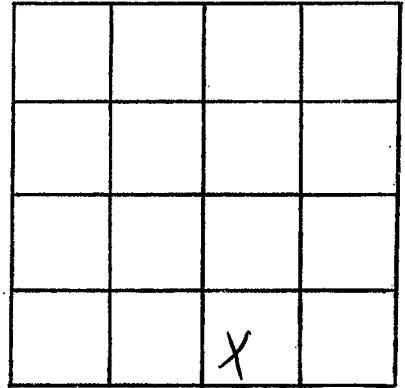

SECTION 29

Please indicate well location X.

ADDITIONAL INFORMATION

If more than one screen, show locations of each on sketch.