

WASHINGTON
G 2088

MISSISSIPPI DEPARTMENT OF NATURAL RESOURCES
Bureau of Land and Water Resources
Southport Mall
P.O. Box 10631
Jackson, Mississippi 39209
WATER WELL DRILLERS LOG

2 sept 1987 Lambert Drillers Wash
date well completed firm name county well located

LANDOWNER:	description of formations encountered	from	to
<u>Noel Harris</u>			
<u>Greenville, Miss.</u> (mailing address)	<u>Clay</u>	<u>0</u>	<u>18</u>
WELL LOCATION: sec. <u>14</u> T. <u>17</u> N. R. <u>9</u> E <u>3</u> miles <u>S/W</u> of <u>Greenville</u> (distance) (direction) (nearest town)	<u>Sand</u>	<u>18</u>	<u>60</u>
WELL PURPOSE: <u>None</u> (home, irrigation, municipal, industrial)	<u>pea gravel</u>	<u>60</u>	<u>90</u>
WELL COMPLETION DATA: (1) diameter (inches) <u>4x2</u>	<u>large rocks</u>	<u>90</u>	<u>101</u>
(2) total depth (feet) <u>510</u>	<u>Clay</u>	<u>101</u>	<u>210</u>
(3) static water level (feet) <u>54</u> below top of ground.	<u>Clay st sand</u>	<u>310</u>	<u>360</u>
(4) casing <u>PUC</u> , <u>480</u> , (material) (depth) <u>4x2</u> If telescope see back. (size)	<u>Sand fine</u>	<u>360</u>	<u>465</u>
(5) screen <u>30</u> , <u>510-480</u> (length) (depth to top) <u>2"</u> , <u>PUC</u> (size) (material)	<u>Sand</u>	<u>465</u>	<u>510</u>
(6) pump <u>1 1/2</u> , <u>30</u> (HP) (yield gpm) <u>elect</u> (type power)			
(7) electric log _____ (yes or no) (organization running log)			
(8) how well bottom plugged <u>back pass</u>			
DRILLERS REMARKS:			

DECEMBER 15 1987

Department of Natural Resources
Bureau of Land and Water Resources


If well telescopes please sketch and show depths.

GROUND LEVEL

140 411

480 2''

570 2'' 50y.

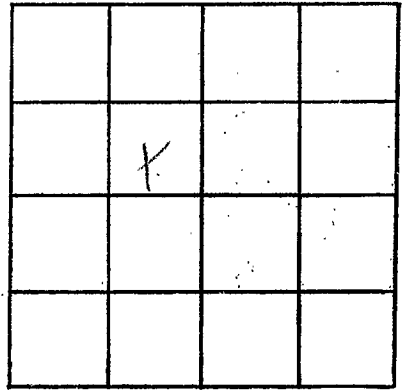

SECTION 14

Please indicate well location X.

ADDITIONAL INFORMATION

If more than one screen,
show locations of each on sketch.