

WASHINGTON  
G 2090

MISSISSIPPI DEPARTMENT OF NATURAL RESOURCES  
Bureau of Land and Water Resources  
Southport Mall  
P.O. Box 10631  
Jackson, Mississippi 39209  
WATER WELL DRILLERS LOG

2-16 1988 Schultz Drilling Washington  
date well completed firm name county well located

LANDOWNER: Robert Folmer  
Lake Lee Road  
Greenville, MS  
(mailing address)

WELL LOCATION:  
sec. 12 T 17 N R 9 E  
4 miles S of Greenville  
(distance) (direction) (nearest town)

description of formations encountered	from	to
CLAY	0	20
SAND	20	107
CLAY	107	140
GRAVEL + SAND	140	165
CLAY	165	270
SAND	270	400

WELL PURPOSE: HOME  
(home, irrigation, municipal, industrial)


- WELL COMPLETION DATA:
- (1) diameter (inches) 4" x 2"
  - (2) total depth (feet) 400'
  - (3) static water level (feet) 32' below above top of ground.
  - (4) casing PVC 380'  
(material) (depth)
  - (size) if telescope see back.
  - (5) screen 20' 380'  
(length) (depth to top)
  - 2" PVC  
(size) (material)
  - (6) pump 1 20  
(HP) (yield gpm)
  - ele  
(type power)
  - (7) electric log No  
(yes or no)
  - X  
(organization running log)
  - (8) how well bottom plugged b/w

RECEIVED  
MAR 11 1988

Department of Natural Resources  
Bureau of Land & Water Resources

DRILLERS REMARKS:

If well telescopes please sketch and show depths.

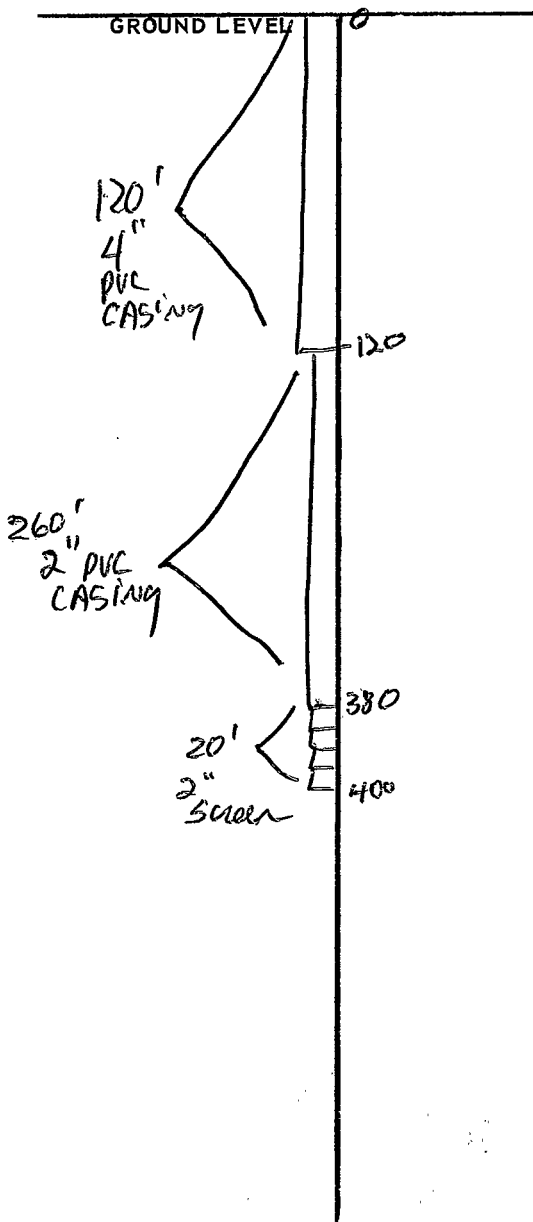

		X	

SECTION 12

Please indicate well location X.

ADDITIONAL INFORMATION

If more than one screen, show locations of each on sketch.