

WASHINGTON
G. J. J. J.

MISSISSIPPI DEPARTMENT OF NATURAL RESOURCES
Bureau of Land and Water Resources
Southport Mall
P.O. Box 10631
Jackson, Mississippi 39209
WATER WELL DRILLERS LOG

2-22-1988 date well completed Scholtz Drilling firm name Washington county well located


LANDOWNER: J. T. THRASH
1614 Robertshaw
Greenville, MS
(mailing address)

description of formations encountered	from	to
	CLAY	0
SHALE	280	360
SAND	360	460

WELL LOCATION:
sec. 12 T. 17 N. R. 8 E.
S W
3 miles S of Greenville
(distance) (direction) (nearest town)

WELL PURPOSE: Home
(Home, irrigation, municipal, industrial)

- WELL COMPLETION DATA:
- (1) diameter (inches) 2"
 - (2) total depth (feet) 460
 - (3) static water level (feet) 38' below top of ground.
 - (4) casing PVC 450'
(material) (depth)
 - (size) if telescope see back.
 - (5) screen 10' 450'
(length) (depth to top)
2" PVC
(size) (material)
 - (6) pump 1 10
(HP) (yield gpm)
ele
(type power)
 - (7) electric log No
(yes or no)
x
(organization running log)
 - (8) how well bottom plugged b/w

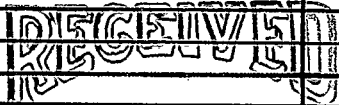

MAR 11 1988

Department of Natural Resources
Bureau of Land & Water Resources

DRILLERS REMARKS:

If well telescopes please sketch and show depths.

GROUND LEVEL

		X	

SECTION 12

Please indicate well location X.

ADDITIONAL INFORMATION

If more than one screen, show locations of each on sketch.