

Washington
9 2082

MISSISSIPPI DEPARTMENT OF NATURAL RESOURCES
 Bureau of Land and Water Resources
 Southport Mall
 P.O. Box 10631
 Jackson, Mississippi 39209
WATER WELL DRILLERS LOG

2-24 1988 date well completed
 Schultz Drilling firm name
 Washington county well located


LANDOWNER: Matt Weissinger
South Main
Greenville, MS
 (mailing address)

description of formations encountered	from	to
CLAY	0	40
FINE SAND	40	80
SHALE	80	340
SAND	340	460

WELL LOCATION:
 sec. 12 T. 17 N. R. 8 E.
1 miles S of Greenville
 (distance) (direction) (nearest town)

WELL PURPOSE: Home
 (home, irrigation, municipal, industrial)

- WELL COMPLETION DATA:
- (1) diameter (inches) 4" x 2"
 - (2) total depth (feet) 460'
 - (3) static water level (feet) 38' below above top of ground.
 - (4) casing PVC 430'
 (material) (depth)
 - if telescope see back.
 (size)
 - (5) screen 30' 430'
 (length) (depth to top)
2" PVC
 (size) (material)
 - (6) pump 1 260'
 (HP) (yield gpm)
ele
 (type power)
 - (7) electric log no
 (yes or no)
X
 (organization running log)
 - (8) how well bottom plugged 4 w

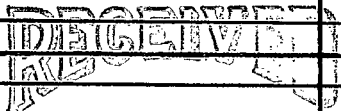

MAR 11 1988

Department of Natural Resources
 Bureau of Land & Water Resources

DRILLERS REMARKS: _____

